

SURVEY & REMONUMENTATION

\$7.00
\$2.00

FEB 14 1997

COMMISSION

LAND CORNER RECORDATION CERTIFICATE
Filing Requirement of Act 74, Mich. P.A. 1970
KENT COUNTY REMONUMENTATION

For corners in

<u>Kent</u> (County)	Located in: Caledonia Township	Corner Code #
1. Public Land Survey	T <u>5N</u> R <u>10W</u>	<u>H-10</u>
	T _____ R _____	_____
	T _____ R _____	_____
	T _____ R _____	_____
2. Property Controlling in Section	S _____ T _____ R _____	_____
	S _____ T _____ R _____	_____
3. Miscellaneous Property in Sec.	S _____ T _____ R _____	_____
	S _____ T _____ R _____	_____

STATE OF MICHIGAN
COUNTY OF KENT
RECEIVED FOR RECORD

96 NOV -8 AM 9:22


REG. OF DEEDS
Luis J. Rana

9517
Register of Deeds Stamp & File Number

4. Lot No. _____, Recorded Plat _____
5. Private Claims _____

I, Randy Kolehouse, in a field survey on March 26 19 96, do hereby certify that under requirements of P.A. 74 Michigan P.A. of 1970, the corner points mentioned in lines 1 and 2 above were in conformance with regulations and rules therefore as required in the current manual of survey instructions of the United States Department of the interior, Bureau of Land Management or by a decree of a Court of Law and/or that the corner points mentioned in lines 3, 4 and 5 above were in conformance with the rules of the Michigan Board of Land Surveyors or by a Decree of a Court of Law; established, re-established, monumented, re-monumented, recovered, found as expressed below:

NOTE: Not more than 4 corners, all in the same town and range, may be recorded on this certificate.

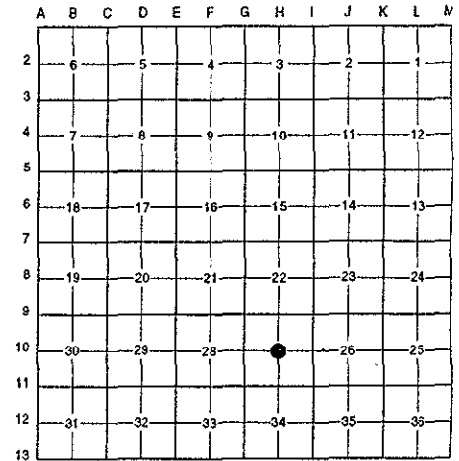

A. Description of original monument and accessories and/or subsequent restoration:

H-10 This corner was not originally set by the G.L.O.

N/A	Witness Map	K.C. Surveyor	Iron
1977	L.C.R.C. #977	Exxel Engineering	PK Nail

P.A. 345 1990 KENT COUNTY
PEER APPROVED 8/22/96
CHAIRMAN *Randy Ruper*

B. Description of corner evidence found and/or method applied in restoring or reestablishing corner:

H-10 Found a 1/2" pipe on the C/L intersection of 96th Street (bit.) running East and West and Alaska Avenue (bit.) running North and South per L.C.R.C.'s #977 and the K.C. Surveyor's records. Pipe is 14.0' East and 9.4' North of the intersection of 1/4 lines and has been held historically as the Center of Section. Accepted pipe as Center of Section.

L.C.R.C. #977

PK in sde guy pole SSE 59.32'
Nail in sde 10" Hickory SSW 64.22'
Nail in side of 32" Ash (stump) West 24.40'

The selected location is accepted by me and is generally accepted by professional surveyors as the best available evidence of the position of the original corner.

C. Description of monument for corner and accessories established to perpetuate locating the position of the corner:

H-10 Replaced 1/2" Pipe with a Standard Kent County Monument

Nail & K.C. remon. tag on W side Guy pole S 15° E 59.32'
Nail & K.C. remon. tag on E side 10" Hickory S 21° W 64.22'
Nail & K.C. remon. tag on SW side P. pole N 20° W 88.22'
Nail & K.C. remon. tag on S side 36" Oak N 82° E 102.16'
Nail & K.C. remon. tag on N side 30" Walnut S 71° E 94.43'

Signed by *Randy J. Kolehouse* Date 10/8/96
EARTH TECH
Surveyor's Michigan License No. 25854

