

FEB 14 1997

COMMISSION

KENT COUNTY REMONUMENTATION

LAND CORNER RECORDATION CERTIFICATE  
Filing Requirement of Act 74, Mich. P.A. 1970

For corners in  
KENT COUNTY

Located In:	Corner Code #
T 5N R 10W	I-1
T R	
T R	
T R	
S T R	
S T R	
S T R	
S T R	

- 1. Public Land Survey
- 2. Property Controlling in Section
- 3. Miscellaneous Property in Sec.

4. Lot No. \_\_\_\_\_, Recorded Plat \_\_\_\_\_  
5. Private Claims \_\_\_\_\_

I, Kirk Breitels, in a field survey on May 16, 19 96 do hereby state that under requirements of P.A. 74, Michigan P.A. of 1970, the corner points mentioned in lines 1 and 2 above were in conformance with regulations and rules therefore as required in the current manual of survey instructions of the United States Department of the Interior, Bureau of Land Management or by a decree of a Court of Law and/or that the corner points mentioned in lines 3, 4 and 5 above were in conformance with the rules of the Michigan Board of Land Surveyors or by a Decree of a Court of Law; established, re-established, monumented, recovered, found as expressed below:

NOTE: Not more than 2 corners, all in the same town and range, may be recorded on this certificate.

STATE OF MICHIGAN  
COUNTY OF KENT  
RECEIVED FOR RECORD  
96 JUN -7 AM 8:29  
REG. OF DEEDS  
*Handwritten Signature*  
**9176**  
Register of Deeds Stamp & File Number

	A	B	C	D	E	F	G	H	I	J	K	L	M
1													
2	6	5	4	3	2	1							
3													
4	7	8	9	10	11	12							
5													
6	18	17	16	15	14	13							
7													
8	19	20	21	22	23	24							
9													
10	30	29	28	27	26	25							
11													
12	31	32	33	34	35	36							
13													

A. Description of original monument and accessories and/or subsequent restoration:

I-1	1830	GLO	Mullett	Set Post
	1974	LCRC #654	Spicer	1" Iron
	1984	LCRC #3822	Chettleburgh	Set Kent County Monument
	1991	LCRC #6051	Unema	Kent County Monument

P.A. 345 1990 KENT COUNTY  
PEER APPROVED 5/30/96  
CHAIRMAN Harry Huber

The position of this corner was previously approved by the Kent County Remonumentation Peer Group, monumented by Thomas Chettleburgh on 4/30/84 and was recorded per LCRC #3822

B. Description of corner evidence found and/or method applied in restoring or reestablishing corner:

I-1 Found Iron (MVK cap) over Kent Co. Mon. (14" deep) per wit. from LCRC as set on Twp. line by T. Chettleburgh in place of the Iron Pipe he found that checks LCRC #654 & GLO Jog. Removed MYK Iron & 10" of Mon. (broken), Set 20" KC Mon. over remains.


LCRC #3822	LCRC #6051
Nail/tag 40" Oak N10°E 15.71'	Nail/tag 46" Oak N00°E 15.68'
Nail/tag P. Pole S22°E 67.97'	Nail/tag 20" Oak N60°W 43.80'
Nail/tag 18" Oak S15°E 97.06'	Nail/tag 42" Oak S12°W 99.34'
Nail/tag 37" Oak S12°W 99.33'	Nail/tag 22" Oak S15°E 97.03'
Nail/tag 19" Oak N60°W 43.78'	Nail/tag T. Pole S20°E 69.94'

The selected location is accepted by me and is generally accepted by professional surveyors as the best available evidence of the position of the original corner.

C. Description of monument for corner and accessories established to perpetuate locating the position of the corner:

I-1 Standard Kent County Monument

New Nail & KC Remon. tag W. side	46" Oak	N00°E	15.68'
Nail & KC Remon. tag SW side	20" Oak	N60°W	43.80'
Nail & KC Remon. tag E. side	48" Oak	S12°W	99.42'
Nail & KC Remon. tag W. side	26" Oak	S15°E	97.08'
Nail & KC Remon. tag SW side	T. Pole	S20°E	68.00'
Kent Co. Mon. (I-13, T6N, R10W)		East	40.24'
C/L E-W grav. road is	6'±	South	
C/L grav. road South is	2 1/2'±	East	

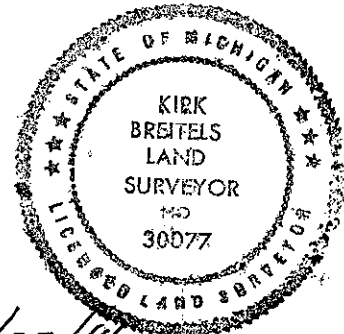

Signed by Kirk Breitels  
Surveyor's Michigan License No. 30077

Date 5/23/96