

**SURVEY & REMONUMENTATION**

FEB 14 1997

COMMISSION

**LAND CORNER RECORDATION CERTIFICATE**  
**Filing Requirement of Act 74, Mich. P.A. 1970**  
**KENT COUNTY REMONUMENTATION**

For corners in

Kent  
 (County)

Located in: Caledonia Township  
 Corner Code #

- |                                    |             |              |            |
|------------------------------------|-------------|--------------|------------|
| 1. Public Land Survey              | T <u>5N</u> | R <u>10W</u> | <u>1-2</u> |
|                                    | T _____     | R _____      | _____      |
|                                    | T _____     | R _____      | _____      |
|                                    | T _____     | R _____      | _____      |
| 2. Property Controlling in Section | S _____     | T _____      | R _____    |
|                                    | S _____     | T _____      | R _____    |
| 3. Miscellaneous Property in Sec.  | S _____     | T _____      | R _____    |
|                                    | S _____     | T _____      | R _____    |

REG. OF DEEDS

9522


Register of Deeds Stamp & File Number

STATE OF MICHIGAN  
 COUNTY OF KENT  
 RECEIVED FOR RECORD  
 96 NOV -8 AM 9:22

4. Lot No. \_\_\_\_\_, Recorded Plat \_\_\_\_\_  
 5. Private Claims \_\_\_\_\_

I, Randy Kolehouse, in a field survey on April 16 19 96, do hereby certify that under requirements of P.A. 74 Michigan P.A. of 1970, the corner points mentioned in lines 1 and 2 above were in conformance with regulations and rules therefore as required in the current manual of survey instructions of the United States Department of the interior, Bureau of Land Management or by a decree of a Court of Law and/or that the corner points mentioned in lines 3, 4 and 5 above were in conformance with the rules of the Michigan Board of Land Surveyors or by a Decree of a Court of Law; established, re-established, monumented, re-monumented, recovered, found as expressed below:

**NOTE: Not more than 4 corners, all in the same town and range, may be recorded on this certificate.**

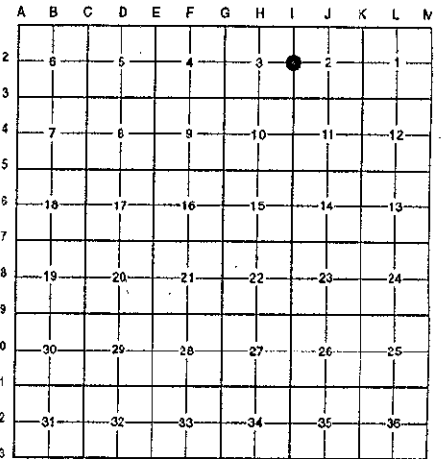

**A. Description of original monument and accessories and/or subsequent restoration:**

I-2	1831	G.L.O. Notes	Mullett	Set Post	P.A. 345 1990 KENT COUNTY
	1964	Witness Map	K.C. Surveyor	Iron	PEER APPROVED 7/25/96
	1976	L.C.R.C. #932	Exxel Engineering	"T" Iron	CHAIRMAN <u>Randy Kolehouse</u>
	1982	L.C.R.C. #3072	Jonker Land Surveys	Fnd. "T" Iron / Set K.C. Monument	
	1995	L.C.R.C. #8112	K. Breitels	K.C. Monument	

This corner was originally approved by the Kent County Remonumentation Peer Group and monumented by Rob Jonker on 8/4/82 and was recorded per L.C.R.C. #3072.

**B. Description of corner evidence found and/or method applied in restoring or reestablishing corner:**

I-2 Found a Standard Kent County Monument in the C/L of Buttrick Avenue (gravel) running North and South, on line of fence running West, 5' South on line of fence running East per L.C.R.C.'s #3072 and #8112 as set by Rob Jonker in place of a "T" iron he found which checked L.C.R.C. #932 and the K.C. Surveyor's records.

L.C.R.C. #3072

L.C.R.C. #8112

Remon. tag on N side 16" Oak N 80° E 32.76'  
 Remon. tag on SW side 18" Oak S 40° E 41.00'  
 Remon. tag on E side 20" Oak S 35° W 45.96'  
 Remon. tag on E side 8" Poplar N 30° W 62.29'  
 Capped Iron - West 33'  
 On C/L N-S gravel  
 On tree & fence line to W & 5' S of fence line to E

Nail & KC Remon. tag N. side 24" Oak N 80° E 32.84' (m. 32.83')  
 Nail & KC Remon. tag SW side 28" Oak S 40° E 40.90'  
 Nail & KC Remon. tag E. side 30" Oak S 35° W 45.75' (m. 45.96')  
 Nail & KC Remon. tag E. side 12" Poplar N 30° W 62.34' (m. 62.30')  
 Capped Iron - West 33'; Iron - East 33'  
 On C/L N-S gravel; On tree & fence line to W & 5' S of fence line to E

The selected location is accepted by me and is generally accepted by professional surveyors as the best available evidence of the position of the original corner.

**C. Description of monument for corner and accessories established to perpetuate locating the position of the corner:**

I-2 Standard Kent County Monument

Nail & K.C. remon. tag on N side 24" Oak N 80° E 32.83'  
 Nail & K.C. remon. tag on SW side 28" Oak S 40° E 40.90'  
 Nail & K.C. remon. tag on E side 30" Oak S 35° W 45.96'  
 Nail & K.C. remon. tag on E side 10" Poplar N 30° W 62.30'  
 Capped Iron West 33.00'  
 Iron East 33.00'

Signed by Randy J. Kolehouse  
 EARTH TECH

Date 10/8/96

Surveyor's Michigan License No. 25854

