

SURVEY & REMONUMENTATION

87.00
32.00

FEB 14 1997

COMMISSION

LAND CORNER RECORDATION CERTIFICATE
Filing Requirement of Act 74, Mich. P.A. 1970
KENT COUNTY REMONUMENTATION

For corners in


Kent (County)	Located in:	Caledonia Township	Corner Code #
1. Public Land Survey	T <u>5N</u>	R <u>10W</u>	<u>1-6</u>
	T _____	R _____	_____
	T _____	R _____	_____
	T _____	R _____	_____
2. Property Controlling in Section	S _____	T _____	R _____
	S _____	T _____	R _____
3. Miscellaneous Property in Sec.	S _____	T _____	R _____
	S _____	T _____	R _____

STATE OF MICHIGAN
 COUNTY OF KENT
 RECEIVED FOR RECORD
 96 NOV -8 AM 9:23
 REG. OF DEEDS
 9525
 Register of Deeds Stamp & File Number

4. Lot No. _____, Recorded Plat _____
 5. Private Claims _____

I, Randy Kolehouse, in a field survey on May 1 19 96, do hereby certify that under requirements of P.A. 74 Michigan P.A. of 1970, the corner points mentioned in lines 1 and 2 above were in conformance with regulations and rules therefore as required in the current manual of survey instructions of the United States Department of the interior, Bureau of Land Management or by a decree of a Court of Law and/or that the corner points mentioned in lines 3, 4 and 5 above were in conformance with the rules of the Michigan Board of Land Surveyors or by a Decree of a Court of Law; established, re-established, monumented, re-monumented, recovered, found as expressed below:

NOTE: Not more than 4 corners, all in the same town and range, may be recorded on this certificate.

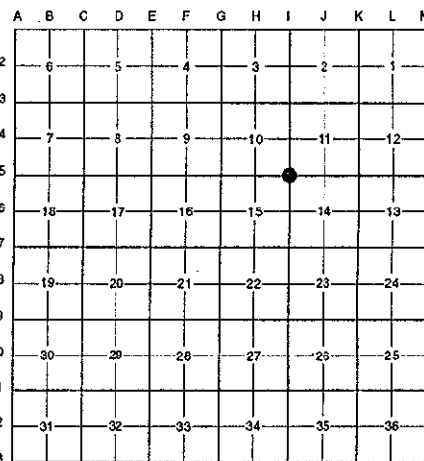

A. Description of original monument and accessories and/or subsequent restoration:

1-5	1831	G.L.O. Notes	Mullett	Set Post
	1957&67	Witness Map	K.C. Surveyor	Iron
	1976	L.C.R.C. #955	P. McPherson	1/2" Pipe
	1982	L.C.R.C. #2673	Jonker Land Survey	Fnd. 1/2" Iron / Set K.C. Monument
	1995	L.C.R.C. #8115	William Byl	K.C. Monument

P.A. 345 1990 KENT COUNTY
 PEER APPROVED 8/22/96
 CHAIRMAN Harry Hubert

This corner was originally approved by the Kent County Remonumentation Peer Group and monumented by Rob Jonker on 3/1/82 and was recorded per L.C.R.C. #2673.

B. Description of corner evidence found and/or method applied in restoring or reestablishing corner:

1-5 Found a Standard Kent County Monument on a North/West/South fence corner per L.C.R.C.'s #2673 and #8115 as set by Rob Jonker in place of a 1/2" iron he found which checked L.C.R.C. #955 and the K.C. Surveyor's records.

L.C.R.C. #2673

Remon. tag on W side 16" Tw. Oak S 13° W 21.40'
 Remon. tag on S side 24" Oak N 60° E 2.14'
 Remon. tag on SW side 9" Oak S 50° W 10.15'
 Remon. tag on W side 18" Hickory N 15° E 14.27'
 At fence corner to N,W,S

L.C.R.C. #8115

Nail & KC Remon. tag W. side 18" Tw. Oak S 13° W 21.31'
 Nail & KC Remon. tag S. side 30" Oak N 60° E 2.15'
 Nail & KC Remon. tag SW side 15" Oak S 50° W 10.14'
 Nail & KC Remon. tag W. side 26" Hickory N 15° E 14.25'
 Nail & KC Remon. tag SW side 10" Maple S 30° E 15.59'
 Nail & KC Remon. tag N. side 12" Hickory N 75° W 22.21'
 At fence corner N,W,S

The selected location is accepted by me and is generally accepted by professional surveyors as the best available evidence of the position of the original corner.

C. Description of monument for corner and accessories established to perpetuate locating the position of the corner:

1-5 Standard Kent County Monument

Nail & K.C. remon. tag on W side 18" Tw. Oak S 13° W 21.31'
 Nail & K.C. remon. tag on S side 30" Oak N 60° E 2.15'
 Nail & K.C. remon. tag on SW side 15" Oak S 50° W 10.14'
 Nail & K.C. remon. tag on W side 26" Hickory N 15° E 14.25'
 Nail & K.C. remon. tag on SW side 10" Maple S 30° E 15.59'
 Nail & K.C. remon. tag on N side 12" Hickory N 75° W 22.21'

Signed by Randy J. Kolehouse
 EARTH TECH

Date 10/9/96

Surveyor's Michigan License No. 25854

