

\$7.00
\$2.00

FEB 14 1997

COMMISSION

LAND CORNER RECORDATION CERTIFICATE
Filing Requirement of Act 74, Mich. P.A. 1970
KENT COUNTY REMONUMENTATION


For corners in

Kent (County)	Located in:	Caledonia Township	Corner Code #
1. Public Land Survey	T <u>5N</u>	R <u>10W</u>	<u>I-8</u>
	T _____	R _____	_____
	T _____	R _____	_____
	T _____	R _____	_____
2. Property Controlling in Section	S _____	T _____	R _____
	S _____	T _____	R _____
3. Miscellaneous Property in Sec.	S _____	T _____	R _____
	S _____	T _____	R _____

STATE OF MICHIGAN
COUNTY OF KENT
RECEIVED FOR RECORD
95 NOV -8 AM 9:23
REG. OF DEEDS
Lucy Standaert
9528
Register of Deeds Stamp & File Number

4. Lot No. _____, Recorded Plat _____
5. Private Claims _____

I, Randy Kolehouse, in a field survey on May 6 19 96, do hereby certify that under requirements of P.A. 74 Michigan P.A. of 1970, the corner points mentioned in lines 1 and 2 above were in conformance with regulations and rules therefore as required in the current manual of survey instructions of the United States Department of the Interior, Bureau of Land Management or by a decree of a Court of Law and/or that the corner points mentioned in lines 3, 4 and 5 above were in conformance with the rules of the Michigan Board of Land Surveyors or by a Decree of a Court of Law; established, re-established, monumented, re-monumented, recovered, found as expressed below:

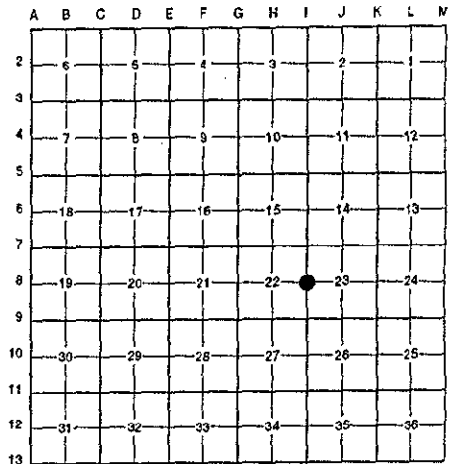

NOTE: Not more than 4 corners, all in the same town and range, may be recorded on this certificate.

A. Description of original monument and accessories and/or subsequent restoration:

I-8	1831	G.L.O. Notes	Mullett	Set Post
	1956	Notes	Williams & Works	2" Dia. Steel Fence Post
	1971	L.C.R.C. #8	Medema, Van Kooten & Assoc.	2" Wood Post / Set "T" Iron in Post
	1984	L.C.R.C. #3830	R. Kolehouse	"T" Iron in 26" Dia. Conc. Cylinder
	1995	L.C.R.C. #8118	K. Breitels	2" Iron in Conc. Cylinder

This corner was originally approved by the Kent County Remonumentation Peer Group and monumented (no monument set) by Randy J. Kolehouse on 3/31/84 and was recorded per L.C.R.C. #3830.

B. Description of corner evidence found and/or method applied in restoring or reestablishing corner:

I-8 Found a 2" iron in a concrete cylinder per L.C.R.C.'s #3830 and #8118 as set by Randy J. Kolehouse which checked L.C.R.C. #3830 and the 1956 notes of Williams & Works.

L.C.R.C. #3830

Nail & K.C. Remon. tag in W. side 16" Maple North 37.74'
Nail & K.C. Remon. tag in NW side 16" Maple N 45° E 29.70'
Nail & K.C. Remon. tag in W. side Twin 12" W. Cherry South 33.93'
Nail & K.C. Remon. tag in SE side 8" Maple S 45° W 29.21'
On line of fences running N,S,E & W

L.C.R.C. #8118


Nail & KC Remon. tag W. side 20" Maple N 00° E 37.67'
Nail & KC Remon. tag NW side 20" Maple N 45° E 26.74'
Nail & KC Remon. tag W. side Tw. 16" W. Cherry S 00° E 33.92'
Nail & KC Remon. tag SE side 12" Maple S 45° W 29.23'
On line of fences running N-S-E-W

The selected location is accepted by me and is generally accepted by professional surveyors as the best available evidence of the position of the original corner.

C. Description of monument for corner and accessories established to perpetuate locating the position of the corner:

I-8 2" Daimeter Iron Pipe in 26" Diameter Concrete Cylinder

Nail & K.C. remon. tag on W side 20" Maple N 00° E 37.67'
Nail & K.C. remon. tag on NW side 20" Maple N 45° E 26.74'
Nail & K.C. remon. tag on W side Tw. 16" W. Cherry S 00° E 33.92'
Nail & K.C. remon. tag on SE side 12" Maple S 45° W 29.23'

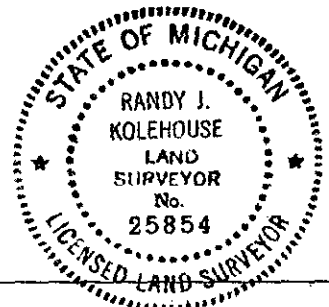

Signed by Randy J. Kolehouse
EARTH TECH

Date 10/8/96

Surveyor's Michigan License No. 25854

P.A. 345 1990 KENT COUNTY
PEER APPROVED, 8/22/96
CHAIRMAN Harry Huber