

87.00
32.00

FEB 14 1997

COMMISSION

LAND CORNER RECORDATION CERTIFICATE
Filing Requirement of Act 74, Mich. P.A. 1970
KENT COUNTY REMONUMENTATION

For corners in

Kent (County)	Located in:	Caledonia Township	Corner Code #
1. Public Land Survey	T <u>5N</u>	R <u>10W</u>	<u>1-13</u>
	T _____	R _____	_____
	T _____	R _____	_____
	T _____	R _____	_____
2. Property Controlling in Section	S _____	T _____	R _____
	S _____	T _____	R _____
3. Miscellaneous Property in Sec.	S _____	T _____	R _____
	S _____	T _____	R _____

STATE OF MICHIGAN
COUNTY OF KENT
RECEIVED FOR RECORD


95 NOV - 8 AM 9:23

REG. OF DEEDS
[Signature]
9533

Register of Deeds Stamp & File Number

4. Lot No. _____, Recorded Plat _____
5. Private Claims _____

I, Randy Kolehouse, in a field survey on April 9 19 96, do hereby certify that under requirements of P.A. 74 Michigan P.A. of 1970, the corner points mentioned in lines 1 and 2 above were in conformance with regulations and rules therefore as required in the current manual of survey instructions of the United States Department of the interior, Bureau of Land Management or by a decree of a Court of Law and/or that the corner points mentioned in lines 3, 4 and 5 above were in conformance with the rules of the Michigan Board of Land Surveyors or by a Decree of a Court of Law; established, re-established, monumented, re-monumented, recovered, found as expressed below:

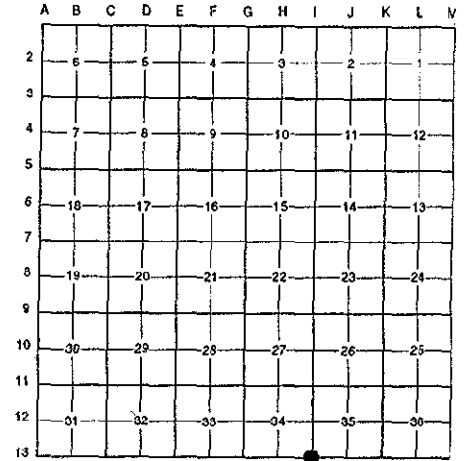

NOTE: Not more than 4 corners, all in the same town and range, may be recorded on this certificate.

A. Description of original monument and accessories and/or subsequent restoration:

I-13	1817	G.L.O. Notes	L. Lyon	Set Post
	1930	Survey #FN 121-9	Williams & Works	Iron in Concrete Monument
	1939	Witness Map	K.C. Surveyor	Monument
	1983	L.C.R.C. #3695	Jonker Land Surveys	Fnd. 1" Solid Bar / Set K.C. Monument
	1995	L.C.R.C. ##8123	K. Breitels	K.C. Monument

P.A. 345 1990 KENT COUNTY
PEER APPROVED 7/25/96
CHAIRMAN *[Signature]*

Note: This corner is not common with I-1, T4N, R10W.

This corner was originally approved by the Kent County Remonumentation Peer Group and monumented by Rob Jonker on 4/6/83 and was recorded per L.C.R.C. #3695.

B. Description of corner evidence found and/or method applied in restoring or reestablishing corner:

I-13 Found a Standard Kent County Monument 2' North of the C/L of 108th Street (bit.) running East and West on line of a tree row running North per L.C.R.C.'s #3695 and #8123 as set by Rob Jonker in place of a 1" solid bar 0.5' below grade in top of a concrete monument he found which checked Williams & Works' Survey #FN 121-9 and the K.C. Surveyor's records.

L.C.R.C. #3695

L.C.R.C. #8123

Capped rerod, #21572, East 34.0' on fence to south
Remon. tag on SW side 30" Tw. Ash S 40° E 44.89'
Remon. tag on N side 12" Ash S 65° W 60.89'
Remon. tag on NE side 10" Ash N 50° W 42.96'
C/L E-W pavt. South 2' m/l

Nail & KC Remon tag N side 15" Ash S 65° W 60.92' (m. 60.85')
Nail & KC Remon tag NE side 15" Ash N 50° W 42.96' (m. 42.87')
Nail & KC Remon tag E. side 18" Elm S 00° E 27.22'
Nail & KC Remon tag NE side 24" Elm S 65° E 64.62' (m. 64.55')
Capped Iron MVK #8618 N 00° E 33.15'
C/L E-W pavt. - South 2' m/l

The selected location is accepted by me and is generally accepted by professional surveyors as the best available evidence of the position of the original corner.

C. Description of monument for corner and accessories established to perpetuate locating the position of the corner.

I-13 Standard Kent County Monument

Nail & K.C. remon. tag on N side 15" Ash S 65° W 60.85'
Nail & K.C. remon. tag on NE side 15" Ash N 50° W 42.87'
Nail & K.C. remon. tag on E side 18" Elm S 00° E 27.22'
Nail & K.C. remon. tag on NE side 24" Elm S 65° E 64.55'
Capped iron N 90° E 34.03'
Capped iron N 00° E 33.15'

Signed by *[Signature]*
EARTH TECH

Date 11/8/96

Surveyor's Michigan License No. 25854

