

**SURVEY &  
REMONUMENTATION**

\$7.00  
\$2.00

FEB 14 1997 **LAND CORNER RECORDATION CERTIFICATE**  
Filing Requirement of Act 74, Mich. P.A. 1970

For corners in COMMISSION **KENT COUNTY REMONUMENTATION**

<u>Kent</u> (County)	Located in: <u>Caledonia</u> Township	Corner Code # <u>J-2</u>
1. Public Land Survey	T <u>5N</u> R <u>10W</u>	<u>J-2</u>
	T _____ R _____	_____
	T _____ R _____	_____
	T _____ R _____	_____
2. Property Controlling in Section	S _____ T _____ R _____	_____
	S _____ T _____ R _____	_____
3. Miscellaneous Property in Sec.	S _____ T _____ R _____	_____
	S _____ T _____ R _____	_____


STATE OF MICHIGAN  
COUNTY OF KENT  
RECEIVED FOR RECORD

96 NOV -8 AM 9:23

REG. OF DEEDS  
*[Signature]*  
**9535**

Register of Deeds Stamp & File Number

4. Lot No. \_\_\_\_\_, Recorded Plat \_\_\_\_\_  
5. Private Claims \_\_\_\_\_

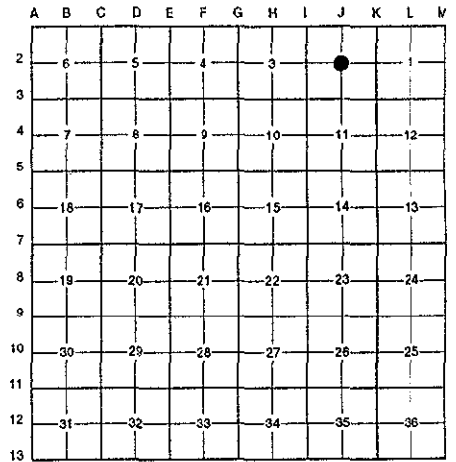

I, Randy Kolehouse, in a field survey on May 2 19 96, do hereby certify that under requirements of P.A. 74 Michigan P.A. of 1970, the corner points mentioned in lines 1 and 2 above were in conformance with regulations and rules therefore as required in the current manual of survey instructions of the United States Department of the interior, Bureau of Land Management or by a decree of a Court of Law and/or that the corner points mentioned in lines 3, 4 and 5 above were in conformance with the rules of the Michigan Board of Land Surveyors or by a Decree of a Court of Law; established, re-established, monumented, re-monumented, recovered, found as expressed below:

**NOTE: Not more than 4 corners, all in the same town and range, may be recorded on this certificate.**

A. Description of original monument and accessories and/or subsequent restoration:

J-2 This corner was not originally set by the G.L.O.

1962	Witness Map	K.C. Surveyor	"X" in Pavement
1973	L.C.R.C. #487	F. Spicer	PK Nail

P.A. 345 1990 KENT COUNTY  
PEER APPROVED 8/22/96  
CHAIRMAN *[Signature]*

B. Description of corner evidence found and/or method applied in restoring or reestablishing corner:

J-2 Found a PK nail 6' ± West of the C/L of Whitneyville Road (bit.) running North and South per L.C.R.C. #487 as set by F. Spicer at the location of the historical Center of Section as used by Williams & Works and the K.C. Surveyor's records. Monument box is 6' East and was set at a later date by the K.C. Road Commission during road construction. PK is 6.1' West and 0.8' South of the intersection of 1/4 lines. Accepted PK nail as Center of Section.


L.C.R.C. #487  
Mon box E 6.05'

The selected location is accepted by me and is generally accepted by professional surveyors as the best available evidence of the position of the original corner.

C. Description of monument for corner and accessories established to perpetuate locating the position of the corner:

J-2 Replaced PK Nail with a Standard Kent County Monument

- Nail & K.C. remon. tag on SW side 16" Oak S 47° E 49.42'
- Nail & K.C. remon. tag on S side of 8" Clump of Elm N 45° E 58.33'
- Nail & K.C. remon. tag on N side 14" Pine N 90° E 79.08'
- Nail & K.C. remon. tag on E side 10" Maple N 10° W 112.60'
- Monument box (capped iron) East 6.05'

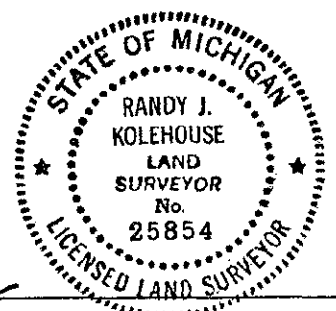

Signed by *[Signature]* Date 10/8/96  
EARTH TECH  
Surveyor's Michigan License No. 25854