

**SURVEY & REMONUMENTATION**

27.00  
22.00

FEB 14 1997

**COMMISSION LAND CORNER RECORDATION CERTIFICATE**  
**Filing Requirement of Act 74, Mich. P.A. 1970**  
**KENT COUNTY REMONUMENTATION**


For corners in

| Kent<br>(County)                      | Located in: Caledonia<br>Township | Corner Code # |
|---------------------------------------|-----------------------------------|---------------|
| 1. Public Land Survey                 | T <u>5N</u> R <u>10W</u>          | <u>J-3</u>    |
|                                       | T _____ R _____                   | _____         |
|                                       | T _____ R _____                   | _____         |
|                                       | T _____ R _____                   | _____         |
| 2. Property Controlling<br>in Section | S _____ T _____ R _____           | _____         |
|                                       | S _____ T _____ R _____           | _____         |
| 3. Miscellaneous<br>Property in Sec.  | S _____ T _____ R _____           | _____         |
|                                       | S _____ T _____ R _____           | _____         |

STATE OF MICHIGAN  
 COUNTY OF KENT  
 RECEIVED FOR RECORD  
 96 NOV -8 AM 9:23  
 REG. OF DEEDS  
 9536  
 Register of Deeds Stamp & File Number

4. Lot No. \_\_\_\_\_, Recorded Plat \_\_\_\_\_  
 5. Private Claims \_\_\_\_\_

I, Randy Kolehouse, in a field survey on April 12 19 96, do hereby certify that under requirements of P.A. 74 Michigan P.A. of 1970, the corner points mentioned in lines 1 and 2 above were in conformance with regulations and rules therefore as required in the current manual of survey instructions of the United States Department of the interior, Bureau of Land Management or by a decree of a Court of Law and/or that the corner points mentioned in lines 3, 4 and 5 above were in conformance with the rules of the Michigan Board of Land Surveyors or by a Decree of a Court of Law; established, re-established, monumented, re-monumented, recovered, found as expressed below:

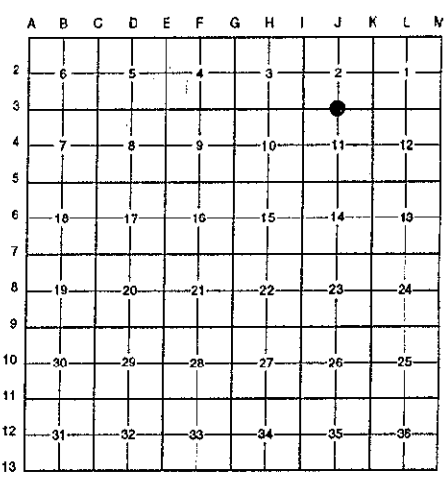

**NOTE: Not more than 4 corners, all in the same town and range, may be recorded on this certificate.**

A. Description of original monument and accessories and/or subsequent restoration:

| J-3 | 1831 | G.L.O. Notes   | Mullett                     | Set Post  |
|-----|------|----------------|-----------------------------|---|
|     | 1963 | Witness Map    | K.C. Surveyor               | Mon. Box  |
|     | 1972 | L.C.R.C. #136  | M. Chambers                 | Iron in Monument Box                                      |
|     | 1972 | L.C.R.C. #163  | Medema, Van Kooten & Assoc. | 1" Iron in Monument Box                                   |
|     | 1981 | L.C.R.C. #2296 | Nederveld & Jonker          | Fnd. Iron in Monument Box / Set K.C. Monument in Mon. Box |
|     | 1995 | L.C.R.C. #8124 | K. Breitels                 | K.C. Monument   |

P.A. 345 1990 KENT COUNTY  
 PEER APPROVED 8/22/96  
 CHAIRMAN Randy Kolehouse

This corner was originally approved by the Kent County Remonumentation Peer Group and monumented by Nederveld & Jonker on 7/24/81 and was recorded per L.C.R.C. #2296.


B. Description of corner evidence found and/or method applied in restoring or reestablishing corner:

| J-3 | L.C.R.C. #2296  | L.C.R.C. #8124                                      |
|-----|---|---|
|     | Nail & K.C. Remon. tag SW side P. pole N 45° W 53.22' | Nail & KC Remon. tag SW side P. Pole N 45° W 53.26' |
|     | N.E. corner conc. sign base S 50° W 59.38'            | NE corner conc. sign base S 50° W 59.34'            |
|     | Nail & K.C. Remon tag SW side P. pole N 55° E 65.40'  | Nail & KC Remon. tag SW side P. Pole N 55° E 65.40' |

The selected location is accepted by me and is generally accepted by professional surveyors as the best available evidence of the position of the original corner.

C. Description of monument for corner and accessories established to perpetuate locating the position of the corner:

| J-3 | Standard Kent County Monument                            |
|-----|--|
|     | Nail & K.C. remon. tag on SW side P. pole N 45° W 53.26' |
|     | Nail & K.C. remon. tag on SW side P. pole N 55° E 65.40' |
|     | NE cor. conc. sign base S 50° W 59.34'                   |
|     | Capped "Roosien" iron #31604 N 90° E 32.97'              |

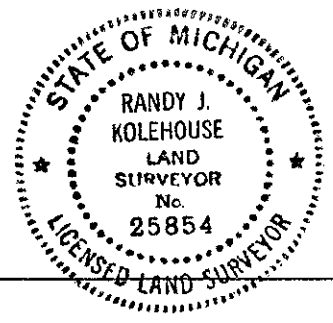

Signed by Randy Kolehouse Date 10/8/96  
 EARTH TECH

Surveyor's Michigan License No. 25854