

SURVEY & REMONUMENTATION

FEB 14 1997


LAND CORNER RECORDATION CERTIFICATE
Filing Requirement of Act 74, Mich. P.A. 1970

For corners in **COMMISSION** KENT COUNTY REMONUMENTATION

Kent (County)	Located in: Caledonia Township	Corner Code #
1. Public Land Survey	T <u>5N</u> R <u>10W</u>	<u>J-8</u>
	T _____ R _____	_____
	T _____ R _____	_____
	T _____ R _____	_____
2. Property Controlling in Section	S _____ T _____ R _____	_____
	S _____ T _____ R _____	_____
3. Miscellaneous Property in Sec.	S _____ T _____ R _____	_____
	S _____ T _____ R _____	_____

STATE OF MICHIGAN
 COUNTY OF KENT
 RECEIVED FOR RECORD
 96 NOV -8 AM 9:23
 REG. OF DEEDS
Lucy [Signature]
 9540
 Register of Deeds Stamp & File Number

4. Lot No. _____, Recorded Plat _____
 5. Private Claims _____

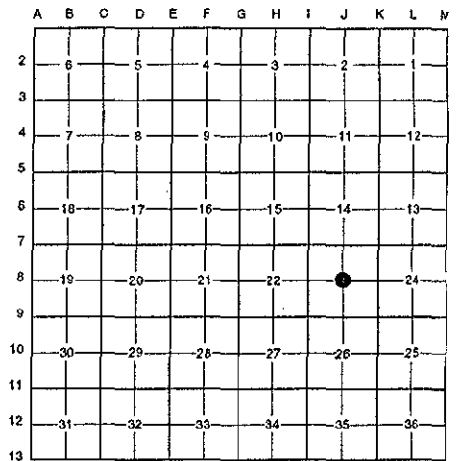

I, Randy Kolehouse, in a field survey on April 8 19 96, do hereby certify that under requirements of P.A. 74 Michigan P.A. of 1970, the corner points mentioned in lines 1 and 2 above were in conformance with regulations and rules therefore as required in the current manual of survey instructions of the United States Department of the interior, Bureau of Land Management or by a decree of a Court of Law and/or that the corner points mentioned in lines 3, 4 and 5 above were in conformance with the rules of the Michigan Board of Land Surveyors or by a Decree of a Court of Law; established, re-established, monumented, re-monumented, recovered, found as expressed below:

NOTE: Not more than 4 corners, all in the same town and range, may be recorded on this certificate.

A. Description of original monument and accessories and/or subsequent restoration:

J-8	This corner was not originally set by the G.L.O.			
1963	Witness Map	K.C. Surveyor	"X" in Concrete	
1976	L.C.R.C. #1002	Medema, Van Kooten & Assoc.	1/2" Iron in Monument Box	
1993	L.C.R.C. #6657	D. Herrema	1/2" Iron in Monument Box	

P.A. 345 1990 KENT COUNTY
 PEER APPROVED 8/22/96
 CHAIRMAN *[Signature]*

B. Description of corner evidence found and/or method applied in restoring or reestablishing corner:

J-8 Found a magnetic nail 2' West of the C/L of Whitneyville Avenue (bit.) running North and South on line of a tree row running East and West per L.C.R.C.'s #1002, #6657 and the K.C. Surveyor's records. Magnetic nail is 5.3' North of the intersection of 1/4 lines. Accepted magnetic nail as Center of Section.

L.C.R.C. #6657

- Nail & tag in NE side 38" Maple NW 68.61'
- Sq. spk in E sde 40" Maple SW 53.35'
- Nail in SE sde 12" Box Elder NE 45.10'
- PK nail in S sde P. Pole E-NE 55.94'
- Sq. spk in N sde 38" Maple West 27.28'

The selected location is accepted by me and is generally accepted by professional surveyors as the best available evidence of the position of the original corner.

C. Description of monument for corner and accessories established to perpetuate locating the position of the corner:

- J-8 Replaced Magnetic Nail with a Standard Kent County Monument
- Nail & K.C. remon. tag on NE side 38" Maple N 23° W 68.61'
- Nail & K.C. remon. tag on E side 40" Maple S 30° W 53.35'
- Nail & K.C. remon. tag on SE side 16" Box Elder N 44° E 45.10'
- Nail & K.C. remon. tag on S side P. pole N 86° E 55.90'
- Nail & K.C. remon. tag on N side 38" Maple N 90° W 27.28'

Signed by *Randy Kolehouse* Date 10/8/96
 EARTH TECH

Surveyor's Michigan License No. 25854

