

SURVEY & REMONUMENTATION

FEB 14 1997

LAND CORNER RECORDATION CERTIFICATE
Filing Requirement of Act 74, Mich. P.A. 1970

COMMISSION

For corners in

KENT COUNTY REMONUMENTATION

| Kent (County) | Located in: Caledonia Township | Corner Code # |
|------------------------------------|--------------------------------|---------------|
| 1. Public Land Survey | T <u>5N</u> R <u>10W</u> | <u>J-9</u> |
| | T _____ R _____ | _____ |
| | T _____ R _____ | _____ |
| | T _____ R _____ | _____ |
| 2. Property Controlling in Section | S _____ T _____ R _____ | _____ |
| | S _____ T _____ R _____ | _____ |
| 3. Miscellaneous Property in Sec. | S _____ T _____ R _____ | _____ |
| | S _____ T _____ R _____ | _____ |

STATE OF MICHIGAN
 COUNTY OF KENT
 RECEIVED FOR RECORD


96 NOV -8 AM 9:23

REG. OF DEEDS
[Signature]
9541

Register of Deeds Stamp & File Number

- 4. Lot No. _____, Recorded Plat _____
- 5. Private Claims _____

I, Randy Kolehouse, in a field survey on April 9 19 96, do hereby certify that under requirements of P.A. 74 Michigan P.A. of 1970, the corner points mentioned in lines 1 and 2 above were in conformance with regulations and rules therefore as required in the current manual of survey instructions of the United States Department of the interior, Bureau of Land Management or by a decree of a Court of Law and/or that the corner points mentioned in lines 3, 4 and 5 above were in conformance with the rules of the Michigan Board of Land Surveyors or by a Decree of a Court of Law; established, re-established, monumented, re-monumented, recovered, found as expressed below:

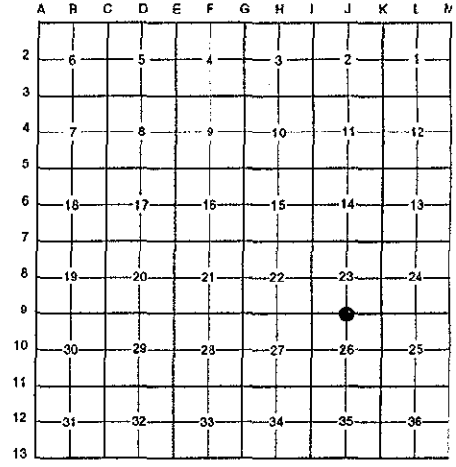

NOTE: Not more than 4 corners, all in the same town and range, may be recorded on this certificate.

A. Description of original monument and accessories and/or subsequent restoration:

| | | | | | |
|-----|------|----------------|--------------------|--------------------------|-------------------------------|
| J-9 | 1831 | G.L.O. Notes | Mullett | Set Post | P.A. 345 1990 KENT COUNTY |
| | 1963 | Witness Map | K.C. Surveyor | 3/4" Iron | PEER APPROVED 7/25/96 |
| | 1974 | L.C.R.C. #654 | F. Spicer | 1" Iron in Mon. Box | CHAIRMAN <i>[Signature]</i> |
| | 1982 | L.C.R.C. #2676 | Jonker Land Survey | Fnd. 1" Iron in Mon. Box | Set K.C. Monument in Mon. Box |
| | 1995 | L.C.R.C. #8128 | K. Breitels | K.C. Monument | |

This corner was originally approved by the Kent County Remonumentation Peer Group and monumented by Rob Jonker on 2/25/82 and was recorded per L.C.R.C. #2676.

B. Description of corner evidence found and/or method applied in restoring or reestablishing corner:

J-9 Found a Standard Kent County Monument 15' West of the C/L of Whitneyville Avenue (bit.) running North and South and the C/L of 92nd Street (bit.) running East and West per L.C.R.C.'s #2676 and #8128 as set by Rob Jonker in place of a 1" solid iron in center line monument box he found which checked L.C.R.C. #654 and the K.C. Surveyor's records.

L.C.R.C. #2676

- Remon. tag on S side 8" Elm S 63° W 74.66'
- Remon. tag on S side p. pole N 72° E 95.60'
- Chisled "X" on top of curb S 55° E 57.75'
- Face concrete R.O.W. marker N 38° E 64.13'
- SE corner church fnd. N 45° W 113.0'


L.C.R.C. #8128

- Nail & KC Remon. tag S. side 14" dead Elm S 63° W 74.66' (m. 74.76')
- Nail & KC Remon. tag S. side P. Pole N 72° E 95.60' (m. 95.55')
- Face concrete R.O.W. marker N 38° E 64.13'
- SE corner house (old church) fnd. (S. corner) N 50° W 114.96' (m. 114.89')
- SE corner house (old church) fnd. N 45° W 113.00' (m. 112.83')
- Nail & KC Remon. tag se side Guy Pole S 70° W 65.38'
- PK Nail & KC Remon. tag in curb joint S 60° E 57.94' (m. 57.90')

The selected location is accepted by me and is generally accepted by professional surveyors as the best available evidence of the position of the original corner.

C. Description of monument for corner and accessories established to perpetuate locating the position of the corner:

- J-9 Standard Kent County Monument
- Nail & K.C. remon. tag on S side 14" dead Elm S 63° W 74.76'
 - Nail & K.C. remon. tag on S side P. pole N 72° E 95.55'
 - SE cor. house fndn. (S'ly) N 50° W 114.89'
 - SE cor. house fndn. N 45° W 112.83'
 - Nail & K.C. remon. tag on SE side Guy pole S 70° W 65.38'
 - Nail & K.C. remon. tag in curb joint S 60° E 57.90'

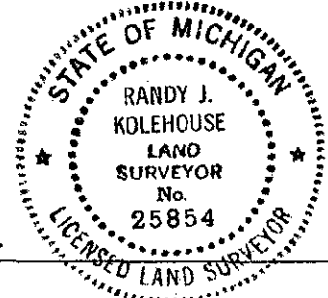

Signed by *[Signature]*
 EARTH TECH

Date 10/8/96

Surveyor's Michigan License No. 25854