

SURVEY &
REMONUMENTATION

FEB 14 1997

LAND CORNER RECORDATION CERTIFICATE
Filing Requirement of Act 74, Mich. P.A. 1970

For corners in COMMISSION

KENT COUNTY REMONUMENTATION

For corners in	Located in:	Corner Code #
<u>Kent</u> (County)	<u>Caledonia</u> Township	
1. Public Land Survey	T <u>5N</u> R <u>10W</u>	<u>K-5</u>
	T _____ R _____	_____
	T _____ R _____	_____
	T _____ R _____	_____
2. Property Controlling in Section	S _____ T _____ R _____	_____
	S _____ T _____ R _____	_____
3. Miscellaneous Property in Sec.	S _____ T _____ R _____	_____
	S _____ T _____ R _____	_____

STATE OF MICHIGAN
COUNTY OF KENT
RECEIVED FOR RECORD

96 NOV -8 AM 9:23

REG. OF DEEDS

Lucy Bond


9554

Register of Deeds Stamp & File Number

4. Lot No. _____, Recorded Plat _____
5. Private Claims _____

I, Randy Kolehouse, in a field survey on April 30 19 96, do hereby certify that under requirements of P.A. 74 Michigan P.A. of 1970, the corner points mentioned in lines 1 and 2 above were in conformance with regulations and rules therefore as required in the current manual of survey instructions of the United States Department of the interior, Bureau of Land Management or by a decree of a Court of Law and/or that the corner points mentioned in lines 3, 4 and 5 above were in conformance with the rules of the Michigan Board of Land Surveyors or by a Decree of a Court of Law; established, re-established, monumented, re-monumented, recovered, found as expressed below:

NOTE: Not more than 4 corners, all in the same town and range, may be recorded on this certificate.

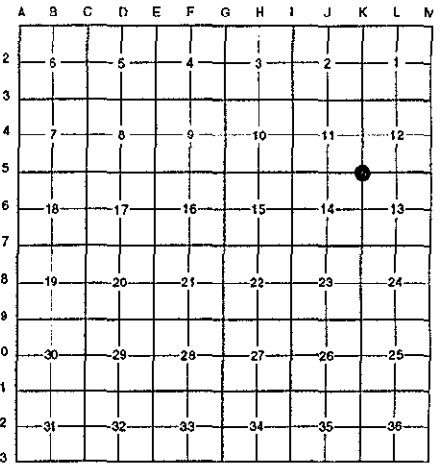

A. Description of original monument and accessories and/or subsequent restoration:

Date	Description	Surveyor	Monument	Approval
K-5 1831	G.L.O. Notes	Mullett	Set Post	P.A. 345 1990 KENT COUNTY
N/A	Witness Map	K.C. Surveyor	3/4" ron	PEER APPROVED <i>8/22/96</i>
1973	L.C.R.C. #407	VanKooten	Iron	CHAIRMAN <i>Randy Kolehouse</i>
1981	L.C.R.C. #2294	Nederveld & Assoc.	Fnd. 3/4" Iron / Set K.C. Monument	
1990	L.C.R.C. #5776	J. Bueche	K.C. Monument (Broken)	
1995	L.C.R.C. #8138	K. Breitels	K.C. Monument	

This corner was originally approved by the Kent County Remonumentation Peer Group and monumented by Nederveld & Associates on 7/24/81 and was recorded per L.C.R.C. #5776.

B. Description of corner evidence found and/or method applied in restoring or reestablishing corner:

K-5 Found a Standard Kent County Monument 3.5' North of the C/L of 76th Street (bit.) running East and West per L.C.R.C.'s #2294, 5776 and #8138 as set by Nederveld & Associates in place of a 3/4" iron they found which checked L.C.R.C. #407 and the K.C. Surveyor's records.

L.C.R.C. #2294

Nail & K.C. Remon. tag S side 30" Oak N 75° E 73.45'
Nail & K.C. Remon. tag W side 26" Oak N 28° E 26.15'
Nail & K.C. Remon. tag W side P. pole S 11° W 52.04'
SE cor. gar. fnd. N 14° W 109.30'
Centerline Gravel Road 3.5' South

L.C.R.C. #8138

Nail & KC Remon. tag S. side 40" Oak N 75° E 73.44'
Nail & KC Remon. tag W. side 36" Oak N 28° E 26.22'
Nail & KC Remon. tag W. side P. Pole S 11° W 52.11'
SE cor. gar. fnd. N 14° W 109.30'
Nail & KC Remon. tag SW side 6" Oak S 45° E 46.67'
Centerline gravel road - 3.5' South

The selected location is accepted by me and is generally accepted by professional surveyors as the best available evidence of the position of the original corner.

C. Description of monument for corner and accessories established to perpetuate locating the position of the corner:

K-5 Standard Kent County Monument

Nail & K.C. remon. tag on S side 40" Oak N 75° E 73.44'
Nail & K.C. remon. tag on W side 36" Oak N 28° E 26.22'
Nail & K.C. remon. tag on W side P. pole S 11° W 52.11'
SE cor. garabe fnd. N 14° W 109.30'
Nail & K.C. remon. tag on SW side 6" Oak S 45° E 46.67'

Signed by *Randy J. Kolehouse*
EARTH TECH

Date 10/8/96

Surveyor's Michigan License No. 25854

