

SURVEY & REMONUMENTATION

FEB 14 1997

LAND CORNER RECORDATION CERTIFICATE
Filing Requirement of Act 74, Mich. P.A. 1970
KENT COUNTY REMONUMENTATION

For corners in

COMMISSION


Kent (County)	Located in: Caledonia Township	Corner Code #
1. Public Land Survey	T <u>5N</u> R <u>10W</u>	<u>K-7</u>
	T _____ R _____	_____
	T _____ R _____	_____
	T _____ R _____	_____
2. Property Controlling in Section	S _____ T _____ R _____	_____
	S _____ T _____ R _____	_____
3. Miscellaneous Property in Sec.	S _____ T _____ R _____	_____
	S _____ T _____ R _____	_____

REG. OF DEEDS
 9556
 Register of Deeds Stamp & File Number

STATE OF MICHIGAN
 COUNTY OF KENT
 RECEIVED FOR RECORD
 96 NOV -8 AM 9:23

4. Lot No. _____, Recorded Plat _____
5. Private Claims _____

I, Randy Kolehouse, in a field survey on April 12 19 96, do hereby certify that under requirements of P.A. 74 Michigan P.A. of 1970, the corner points mentioned in lines 1 and 2 above were in conformance with regulations and rules therefore as required in the current manual of survey instructions of the United States Department of the interior, Bureau of Land Management or by a decree of a Court of Law and/or that the corner points mentioned in lines 3, 4 and 5 above were in conformance with the rules of the Michigan Board of Land Surveyors or by a Decree of a Court of Law; established, re-established, monumented, re-monumented, recovered, found as expressed below:

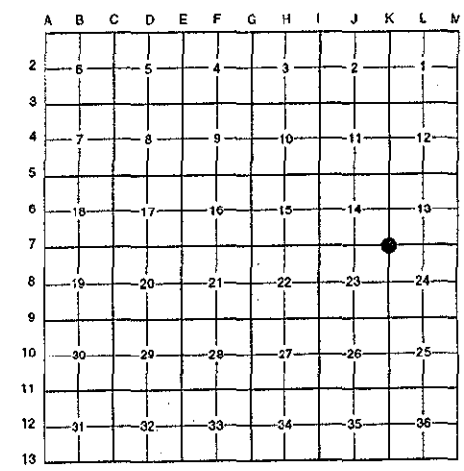

NOTE: Not more than 4 corners, all in the same town and range, may be recorded on this certificate.

A. Description of original monument and accessories and/or subsequent restoration:

K-7	1831	G.L.O. Notes	Mullett	Set Post
	N/A	Witness Map	K.C. Surveyor	Monument Box
	1972	L.C.R.C. #149	Medema, Van Kooten & Assoc.	Iron in Monument Box
	1981	L.C.R.C. #2298	Nederveld Associates Surveying	Fnd. Iron in Mon. Box / Set K.C. Monument in Mon. Box
	1995	L.C.R.C. #8140	K. Breitels	K.C. Monument

P.A. 345 1990 KENT COUNTY
 PEER APPROVED 7/25/96
 CHAIRMAN Harry Huber

This corner was originally approved by the Kent County Remonumentation Peer Group and monumented by Nederveld Associates Surveying on 1/30/95 and was recorded per L.C.R.C. #8140.

B. Description of corner evidence found and/or method applied in restoring or reestablishing corner:

K-7 Found a Standard Kent County Monument in a monument box 0.5' North of the C/L of 84th Street (bit.) running East and West per L.C.R.C.'s #2287 and #8140 as set by Nederveld Associates Surveying in place of an iron in the Westerly side of a monument box they found which checked L.C.R.C. #149 and the K.C. Surveyor's records.

L.C.R.C. #2298	L.C.R.C. #8140
Nail & K.C. Remon. tag N side 1" Oak S 62° E 72.25'	Nail & KC Remon. tag N. side 24" Oak S 62° E 72.16'
Nail & K.C. Remon. tag N side 18" Oak N 60° E 56.48'	Nail & KC Remon. tag N. side 30" Oak N 60° E 56.48'
Nail & K.C. Remon. tag N side 18" Oak S 34° W 29.37'	Nail & KC Remon. tag N. side 30" Oak S 68° W 81.56'
Nail & K.C. Remon. tag N side 20" Oak S 68° W 81.71'	Nail & KC Remon. tag S. side 32" Oak N 70° W 92.95'
Centerline B.T. 0.5' South	Nail & KC Remon. tag W. side Tw. 20" Oak N 15° E 29.88'
	Centerline B.T. - 0.5' South

The selected location is accepted by me and is generally accepted by professional surveyors as the best available evidence of the position of the original corner.

C. Description of monument for corner and accessories established to perpetuate locating the position of the corner:

K-7 Standard Kent County Monument in a Monument Box

Nail & K.C. remon. tag on N side 24" Oak S 62° E 72.16'
 Nail & K.C. remon. tag on N side 30" Oak N 60° E 56.48'
 Nail & K.C. remon. tag on N side 30" Oak S 68° W 81.56'
 Nail & K.C. remon. tag on S side 32" Oak N 70° W 92.95'
 Nail & K.C. remon. tag on W side Tw. 20" Oak N 15° E 29.88'
 Centerline B.T. - 0.5' South

Signed by Randy J. Kolehouse Date 10/8/96
 EARTH TECH
 Surveyor's Michigan License No. 25854

