

SURVEY & REMONUMENTATION

FEB 14 1997

LAND CORNER RECORDATION CERTIFICATE
Filing Requirement of Act 74, Mich. P.A. 1970
KENT COUNTY REMONUMENTATION


For corners in **COMMISSION**

Kent (County)	Located in: Caledonia Township	Corner Code #
1. Public Land Survey	T <u>5N</u> R <u>10W</u>	<u>K-9</u>
	T _____ R _____	_____
	T _____ R _____	_____
	T _____ R _____	_____
2. Property Controlling in Section	S _____ T _____ R _____	_____
	S _____ T _____ R _____	_____
3. Miscellaneous Property in Sec.	S _____ T _____ R _____	_____
	S _____ T _____ R _____	_____

STATE OF MICHIGAN
 COUNTY OF KENT
 RECEIVED FOR RECORD
 96 NOV -8 AM 9:23
 REG. OF DEEDS
Lucy St. Paul
 9558
 Register of Deeds Stamp & File Number

4. Lot No. _____, Recorded Plat _____
 5. Private Claims _____

I, Randy Kolehouse, in a field survey on April 9 19 96, do hereby certify that under requirements of P.A. 74 Michigan P.A. of 1970, the corner points mentioned in lines 1 and 2 above were in conformance with regulations and rules therefore as required in the current manual of survey instructions of the United States Department of the interior, Bureau of Land Management or by a decree of a Court of Law and/or that the corner points mentioned in lines 3, 4 and 5 above were in conformance with the rules of the Michigan Board of Land Surveyors or by a Decree of a Court of Law; established, re-established, monumented, re-monumented, recovered, found as expressed below:

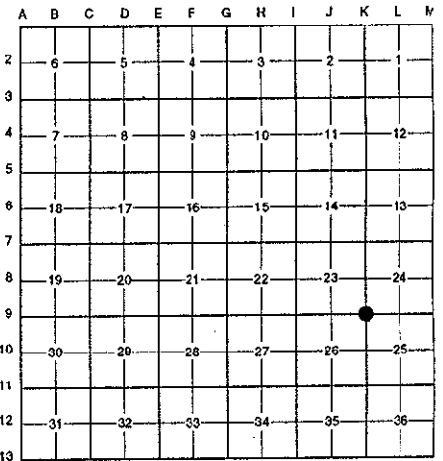

NOTE: Not more than 4 corners, all in the same town and range, may be recorded on this certificate.

A. Description of original monument and accessories and/or subsequent restoration:

K-9	1831	G.L.O. Notes	Mullett	Set Post	P.A. 345 1990 KENT COUNTY
	N/A	Witness Map	K.C. Surveyor	Iron	PEER APPROVED <u>7/29/96</u>
	1974	L.C.R.C. #654	F. Spicer	3/4" Iron	CHAIRMAN <i>Randy Kolehouse</i>
	1982	L.C.R.C. #2691	Jonker Land Surveys	Fnd. 3/4" Iron / Set K.C. Monument	
	1995	L.C.R.C. #8142	K. Breitels	K.C. Monument	

This corner was originally approved by the Kent County Remonumentation Peer Group and monumented by Rob Jonker on 3/16/82 and was recorded per L.C.R.C. #2691.

B. Description of corner evidence found and/or method applied in restoring or reestablishing corner:

K-9 Found a Standard Kent County Monument on the C/L of 92nd Street (bit.) running East and West and 33' East of the C/L of Lakefield Ct. running North and South per L.C.R.C.'s #2691 and #8142 as set by Rob Jonker in place of a 3/4" iron he found which checked L.C.R.C. #654 and the K.C. Surveyor's records.

L.C.R.C. #2691

L.C.R.C. #8142

- Remon. tag on SE side 30" Oak N 80° E 119.6'
- Remon. tag on E side 6" W. Cherry S 25° E 61.00'
- Remon. tag on E side 6" tw. W. Cherry S 00° E 65.68'
- Remon. tag on NW side 24" Box Elder S 57° W 50.78'

- Nail & KC Remon. tag SE side 36" Oak N 80° E 119.62'
- Nail & KC Remon. tag E. side 12" W. Cherry S 25° E 60.83'
- Nail & KC Remon. tag E. side 12" Tw. W. Cherry S 00° E 54.72'
- Nail & KC Remon. tag NW side 32" Box Elder S 57° W 51.03'
- Exxel capped iron - North 33.00'; All Points capped iron - South 32.95'
- On C/L E-W paement, in line with fence to South, tree line ext. from North

The selected location is accepted by me and is generally accepted by professional surveyors as the best available evidence of the position of the original corner.

C. Description of monument for corner and accessories established to perpetuate locating the position of the corner:

K-9 Standard Kent County Monument

- Nail & K.C. remon. tag on SE side 36" Oak N 80° E 119.62'
- Nail & K.C. remon. tag on E side 12" W. Cherry S 25° E 60.83'
- Nail & K.C. remon. tag on E side 12" Twin W. Cherry S 00° E 54.72'
- Nail & K.C. remon. tag on NW side 32" Box Elder S 57° W 51.03'
- All points - capped iron South 32.95'

Signed by *Randy Kolehouse* Date 10/8/96

Surveyor's Michigan License No. 25854

