

SURVEY &  
REMONUMENTATION

FEB 14 1997

LAND CORNER RECORDATION CERTIFICATE  
Filing Requirement of Act 74, Mich. P.A. 1970  
KENT COUNTY REMONUMENTATION


For corners in COMMISSION  
Kent (County) Located in: Caledonia Township Corner Code #

- |                                    |             |              |             |
|------------------------------------|-------------|--------------|-------------|
| 1. Public Land Survey              | T <u>5N</u> | R <u>10W</u> | <u>K-12</u> |
|                                    | T _____     | R _____      | _____       |
|                                    | T _____     | R _____      | _____       |
|                                    | T _____     | R _____      | _____       |
| 2. Property Controlling in Section | S _____     | T _____      | R _____     |
|                                    | S _____     | T _____      | R _____     |
| 3. Miscellaneous Property in Sec.  | S _____     | T _____      | R _____     |
|                                    | S _____     | T _____      | R _____     |

STATE OF MICHIGAN  
COUNTY OF KENT  
RECEIVED FOR RECORD  
96 NOV -8 AM 9:24  
REG. OF DEEDS  
*Lucy [Signature]*  
9561  
Register of Deeds Stamp & File Number

4. Lot No. \_\_\_\_\_, Recorded Plat \_\_\_\_\_  
5. Private Claims \_\_\_\_\_

I, Randy Kolehouse, in a field survey on May 1 1996, do hereby certify that under requirements of P.A. 74 Michigan P.A. of 1970, the corner points mentioned in lines 1 and 2 above were in conformance with regulations and rules therefore as required in the current manual of survey instructions of the United States Department of the interior, Bureau of Land Management or by a decree of a Court of Law and/or that the corner points mentioned in lines 3, 4 and 5 above were in conformance with the rules of the Michigan Board of Land Surveyors or by a Decree of a Court of Law; established, re-established, monumented, re-monumented, recovered, found as expressed below:

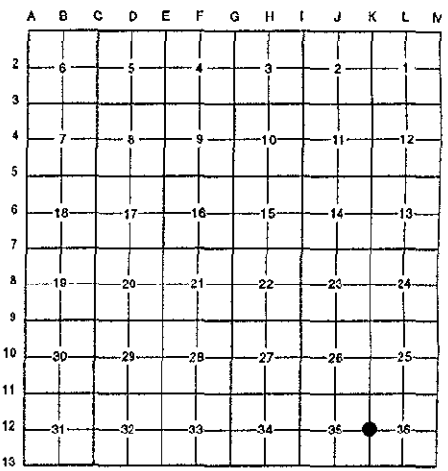

NOTE: Not more than 4 corners, all in the same town and range, may be recorded on this certificate.

A. Description of original monument and accessories and/or subsequent restoration:

K-12	1831	G.L.O. Notes	Mullett	Set Post
	1966	Witness Map	K.C. Surveyor	Iron
	1973	L.C.R.C. #528	Exxel Engineering	"T" Iron
	1982	L.C.R.C. #2680	Jonker Land Survey	Fnd. "T" Iron / Set K.C. Monument
	1995	L.C.R.C. #8145	K. Breitels	K.C. Monument

P.A. 345 1990 KENT COUNTY  
PEER APPROVED 8/22/96  
CHAIRMAN [Signature]

This corner was originally approved by the Kent County Remonumentation Peer Group and monumented by Rob Jonker on 3/3/82 and was recorded per L.C.R.C. #2680.

B. Description of corner evidence found and/or method applied in restoring or reestablishing corner:

K-12 Found a Standard Kent County Monument 3' East of fence line running South and 11' East of fence running North per L.C.R.C.'s #2680 and #8145 as set by Rob Jonker in place of a "T" iron he found which checked L.C.R.C. #528 and the K.C. Surveyor's records.

L.C.R.C. #2680

- Remon. tag on E side 12" Walnut S 00° W 83.38'
- Remon. tag on SW side 8" Locust S 30° E 50.73'
- Remon. tag on N side p. pole N 90° E 57.08'
- Remon. tag on SE side 14" Twin Oak S 47° W 74.92'
- Remon. tag on S side corner fe. post West 3.38'
- On E-W fence & power line & 3' E of fence to S & 11' E of fence to N

L.C.R.C. #8145

- Nail & KC Remon. tag E. side 20" Walnut S 00° W 83.45'
- Nail & KC Remon. tag SW side 15" Locust S 30° E 50.88'
- Nail & KC Remon. tag N. side P. Pole N 90° E 57.15'
- Nail & KC Remon. tag SE side 20" Tw. Oak S 47° W 75.03'
- Nail & KC Remon. tag S. side cor. fence post West 3.49'
- On E-W fence & power line & 3' E. of fence to S. & 11' E. of fence to N.

The selected location is accepted by me and is generally accepted by professional surveyors as the best available evidence of the position of the original corner.

C. Description of monument for corner and accessories established to perpetuate locating the position of the corner:

K-12 Standard Kent County Monument

- Nail & K.C. remon. tag on E side 20" Walnut S 00° W 83.45'
- Nail & K.C. remon. tag on SW side 15" Locust S 30° E 50.88'
- Nail & K.C. remon. tag on N side P. Pole N 90° E 57.15'
- Nail & K.C. remon. tag on SE side 20" Tw. Oak S 47° W 75.03'
- Nail & K.C. remon. tag on S side cor. fence post West 3.49'

Signed by Randy J. Kolehouse  
EARTH TECH

Date 10/8/96

Surveyor's Michigan License No. 25854

