

\$7.00
\$2.00

FEB 14 1997

LAND CORNER RECORDATION CERTIFICATE
Filing Requirement of Act 74, Mich. P.A. 1970
KENT COUNTY REMONUMENTATION

For corners in

COMMISSION

Kent (County)	Located in: Caledonia Township	Corner Code #
1. Public Land Survey	T <u>5N</u> R <u>10W</u>	<u>L-1</u>
	T _____ R _____	_____
	T _____ R _____	_____
	T _____ R _____	_____
2. Property Controlling in Section	S _____ T _____ R _____	_____
	S _____ T _____ R _____	_____
3. Miscellaneous Property in Sec.	S _____ T _____ R _____	_____
	S _____ T _____ R _____	_____

STATE OF MICHIGAN
COUNTY OF KENT
RECEIVED FOR RECORD

96 NOV -8 AM 9:24

REG. OF DEEDS
Luis Standa

9563

Register of Deeds Stamp & File Number

- 4. Lot No. _____, Recorded Plat _____
- 5. Private Claims _____

A	B	C	D	E	F	G	H	I	J	K	L	M
2	6	5	4	3	2	1						
3												
4	7	8	9	10	11	12						
5												
6	18	17	16	15	14	13						
7												
8	19	20	21	22	23	24						
9												
10	30	29	28	27	26	25						
11												
12	31	32	33	34	35	36						
13												

I, Randy Kolehouse, in a field survey on April 30 19 96, do hereby certify that under requirements of P.A. 74 Michigan P.A. of 1970, the corner points mentioned in lines 1 and 2 above were in conformance with regulations and rules therefore as required in the current manual of survey instructions of the United States Department of the interior, Bureau of Land Management or by a decree of a Court of Law and/or that the corner points mentioned in lines 3, 4 and 5 above were in conformance with the rules of the Michigan Board of Land Surveyors or by a Decree of a Court of Law; established, re-established, monumented, re-monumented, recovered, found as expressed below:

NOTE: Not more than 4 corners, all in the same town and range, may be recorded on this certificate.

A. Description of original monument and accessories and/or subsequent restoration:

- L-1 This corner was not originally set by the G.L.O.
- | | | | |
|------|----------------|-----------------------------|--|
| 1963 | Witness Map | K.C. Surveyor | 3/4" Iron |
| 1978 | L.C.R.C. #1137 | Medema, Van Kooten & Assoc. | Square Spike |
| 1982 | L.C.R.C. #2843 | Jonker Land Survey | Fnd. 3/4" Rd. Iron / Set K.C. Monument |
| 1991 | L.C.R.C. #6058 | R. Unema | K.C. Monument |

P.A. 345 1990 KENT COUNTY
PEER APPROVED 10/22/96
CHAIRMAN Stan Huber

Note: This corner is common with L-13, T6N, R10W.

This corner was originally approved by the Kent County Remonumentation Peer Group and monumented by Rob Jonker on 4/28/82 and was recorded per L.C.R.C. #2843.

B. Description of corner evidence found and/or method applied in restoring or reestablishing corner:

- L-1 Found a Standard Kent County Monument 1.0' North of the C/L of 60th Street (bit.) running East and West on line of a fence line running South per L.C.R.C.'s #2843 and #6058 as set by Rob Jonker in place of a 3/4" road iron 31" below grade he found which checked L.C.R.C. #1137 and the K.C. Surveyor's records.

L.C.R.C. #2843

L.C.R.C. #6058


Remon. tag on NW side 18" Oak S 40° W 68.74'
Remon. tag on SW side 4" Elm S 35° E 75.55'
Sq. spike on W side 14" Oak N 00° W 81.57'
Sq. spike on W side 18" Oak S 00° W 46.81'
Corner is 1.5' N of C/L E-W pvt.
On Line old fence & tree lines to N & S

Nail & remon tag in NW side 22" Oak S 40° W 68.78' (m. 68.80')
Nail & remon tag in SW side 10" Elm S 35° E 75.42'
Nail & remon tag in W side twin 20" Oak S 00° E 46.84'
Nail & remon tag in W side 18" Oak N 00° E 81.70' (m. 80.54')
On line old fence to South
C/L BT 60th St. South 1.0' +C/L BT 60th St. South 1.0' ±

The selected location is accepted by me and is generally accepted by professional surveyors as the best available evidence of the position of the original corner

C. Description of monument for corner and accessories established to perpetuate locating the position of the corner:

- L-1 Standard Kent County Monument
- Nail & K.C. remon. tag on NW side 22" Oak S 40° W 68.80'
Nail & K.C. remon. tag on SW side 10" Elm S 35° E 75.42'
Nail & K.C. remon. tag on W side 20" Twin Oak S 00° E 46.84'
Nail & K.C. remon. tag on W side 18" Oak N 00° E 80.54'

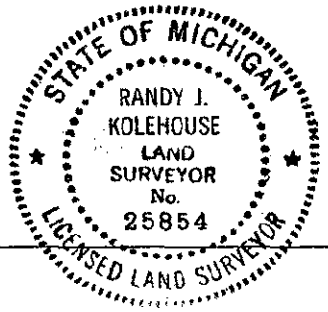

Signed by Randy J. Kolehouse
EARTH TECH

Date 10/8/96

Surveyor's Michigan License No. 25854