

FEB 14 1997

COMMISSION


LAND CORNER RECORDATION CERTIFICATE
Filing Requirement of Act 74, Mich. P.A. 1970
KENT COUNTY REMONUMENTATION

For corners in

Table with columns: Kent (County), Located in: Caledonia Township, Corner Code #. Rows include Public Land Survey, Property Controlling in Section, Miscellaneous Property in Sec.

Register of Deeds Stamp & File Number. Includes date 96 NOV -8 AM 9:24, file number 9564, and State of Michigan County of Kent RECEIVED FOR RECORD stamp.

4. Lot No. , Recorded Plat
5. Private Claims

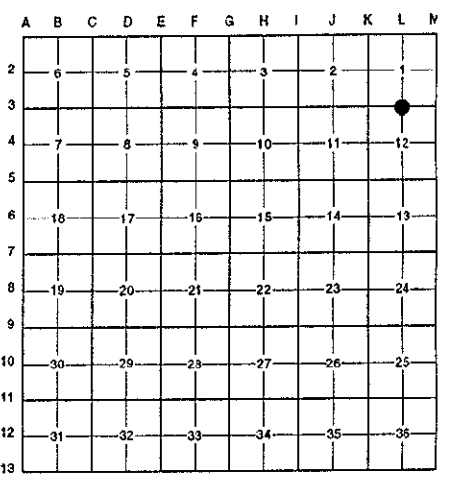

I, Randy Kolehouse, in a field survey on April 9 19 96, do hereby certify that under requirements of P.A. 74 Michigan P.A. of 1970, the corner points mentioned in lines 1 and 2 above were in conformance with regulations and rules therefore as required in the current manual of survey instructions of the United States Department of the interior, Bureau of Land Management or by a decree of a Court of Law and/or that the corner points mentioned in lines 3, 4 and 5 above were in conformance with the rules of the Michigan Board of Land Surveyors or by a Decree of a Court of Law; established, re-established, monumented, re-monumented, recovered, found as expressed below:

NOTE: Not more than 4 corners, all in the same town and range, may be recorded on this certificate.

A. Description of original monument and accessories and/or subsequent restoration:

Table with columns: L-3, 1831, G.L.O. Notes, Witness Map, L.C.R.C. #30, #2293, #8146, Mullett, K.C. Surveyor, F. Spicer, Nederveld Associates, K. Breitels, Set Post, Iron, Iron, Fnd. 3/4" Round Iron / Set K.C. Monument, K.C. Monument.

P.A. 345 1990 KENT COUNTY PEER APPROVED 8/22/96 CHAIRMAN Harry Muehler

This corner was originally approved by the Kent County Remonumentation Peer Group and monumented by Nederveld Associates on 7/24/81 and was recorded per L.C.R.C. #2293.

B. Description of corner evidence found and/or method applied in restoring or reestablishing corner:

L-3 Found a Standard Kent County Monument 1.0' South of the C/L of 68th Street (bit.) running East and West per L.C.R.C.'s #2293 and #8146 as set by Nederveld Associates in place of a iron they found which checked L.C.R.C. #30 and the K.C. Surveyor's records.

L.C.R.C. #2293

L.C.R.C. #8146

Nail & K.C. Remon. tag S side 8" Elm N 60° W 83.42'
Nail & K.C. Remon. tag E side 6" Elm S 45° W 49.55'
Centerline B.T. 1' North


Nail & KC Remon. tag S. side 18" Elm N 60° W 83.47'
Nail & KC Remon. tag E. side 12" Elm S 45° W 49.57'
Nail & KC Remon. tag W. side 14" Elm S 00° E 34.76'
Centerline of B.T. is 1' North
"T" Iron N 00° E 33.00'

The selected location is accepted by me and is generally accepted by professional surveyors as the best available evidence of the position of the original corner.

C. Description of monument for corner and accessories established to perpetuate locating the position of the corner:

L-3 Standard Kent County Monument

Nail & K.C. remon. tag on S side 18" Elm N 60° W 83.47'
Nail & K.C. remon. tag on E side 12" Elm S 45° W 49.57'
Nail & K.C. remon. tag on W side 14" Elm S 00° E 34.76'
"T" Iron N 00° E 33.00'

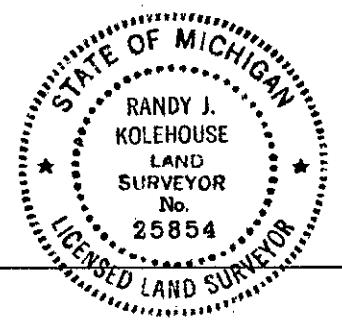

Signed by Randy J. Kolehouse Date 10/8/96

Surveyor's Michigan License No. 25854