

\$7.00
\$2.00

FEB 14 1997

COMMISSION

LAND CORNER RECORDATION CERTIFICATE
Filing Requirement of Act 74, Mich. P.A. 1970
KENT COUNTY REMONUMENTATION

For corners in

Kent (County)	Located in: Caledonia Township	Corner Code #
1. Public Land Survey	T <u>5N</u> R <u>10W</u>	<u>L-6</u>
	T _____ R _____	_____
	T _____ R _____	_____
	T _____ R _____	_____
2. Property Controlling in Section	S _____ T _____	_____
	S _____ T _____	_____
3. Miscellaneous Property in Sec.	S _____ T _____	_____
	S _____ T _____	_____


STATE OF MICHIGAN
COUNTY OF KENT
RECEIVED FOR RECORD

96 NOV -8 AM 9:24

REG. OF DEEDS
Randy Kolehouse

9566
Register of Deeds Stamp & File Number

4. Lot No. _____, Recorded Plat _____
5. Private Claims _____

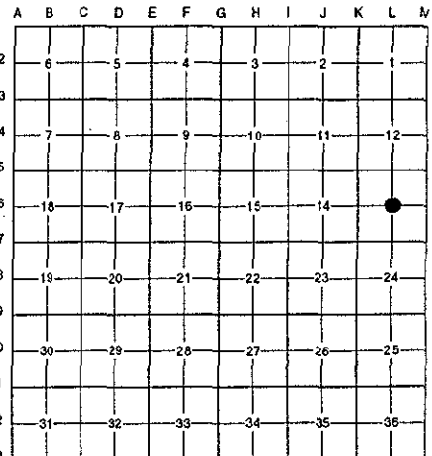

I, Randy Kolehouse, in a field survey on May 2 19 96, do hereby certify that under requirements of P.A. 74 Michigan P.A. of 1970, the corner points mentioned in lines 1 and 2 above were in conformance with regulations and rules therefore as required in the current manual of survey instructions of the United States Department of the interior, Bureau of Land Management or by a decree of a Court of Law and/or that the corner points mentioned in lines 3, 4 and 5 above were in conformance with the rules of the Michigan Board of Land Surveyors or by a Decree of a Court of Law; established, re-established, monumented, re-monumented, recovered, found as expressed below:

NOTE: Not more than 4 corners, all in the same town and range, may be recorded on this certificate.

A. Description of original monument and accessories and/or subsequent restoration:

L-6 This corner was not originally set by the G.L.O.

1965	Witness Map	K.C. Surveyor	Fence Corner
1972	L.C.R.C. #149	Medema, Van Kooten & Assoc.	3/4" Iron

P.A. 345 1990 KENT COUNTY
PEER APPROVED 10/22/96
CHAIRMAN *Harry Hubert*

B. Description of corner evidence found and/or method applied in restoring or reestablishing corner:

L-6 Found a 3/4" steel pipe on line of a tree row running East and West at a fence row running North and South per L.C.R.C. #149 and the K.C. Surveyor's records. Pipe is 0.2' East of the intersection of 1/4 lines. Accepted pipe as the Center of Section.

L.C.R.C. #149


Fence corner is 3'N & 4.3' West
12" Hickory SW 4.9' (m. 5.30')
10" Apple W 24.9' (m. 25.12')

The selected location is accepted by me and is generally accepted by professional surveyors as the best available evidence of the position of the original corner.

C. Description of monument for corner and accessories established to perpetuate locating the position of the corner:

L-6 Replaced Pipe with a Standard Kent County Monument

- Nail & K.C. remon. tag on SE side 12" Hickory S 45° W 5.30'
- Nail & K.C. remon. tag on N side 12" Apple S 85° W 25.12'
- Nail & K.C. remon. tag on NW side 8" Ash N 55° E 5.95'
- Nail & K.C. remon. tag on S side 28" Oak N 80° E 29.57'

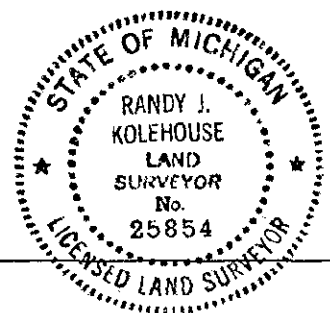

Signed by *Randy J. Kolehouse*
EARTH TECH

Date 10/8/96

Surveyor's Michigan License No. 25854