

SURVEY & REMONUMENTATION

FEB 14 1997

KENT COUNTY REMONUMENTATION

COMMISSION LAND CORNER RECORDATION CERTIFICATE
Filing Requirement of Act 74, Mich. P.A. 1970

For corners in
KENT COUNTY
(County)

Located In: _____ Corner Code # _____

1. Public Land Survey	T 6N R 10W	M 13
	T 5N R 10W	M-1
	T 6N R 9W	A 13
	T 5N R 9W	A 1
2. Property Controlling in Section	S _____ T _____ R _____	_____
3. Miscellaneous Property in Sec.	S _____ T _____ R _____	_____

STATE OF MICHIGAN
COUNTY OF KENT
RECEIVED FOR RECORD
96 MAR 20 AM 8:48
REG. OF DEEDS
Lucy Spauld

9010

Register of Deeds Stamp & File Number

4. Lot No. _____, Recorded Plat _____
5. Private Claims _____

I, Kirk Breitels, in a field survey on Feb. 1, 1996 do hereby state that under requirements of P.A. 74, Michigan P.A. of 1970, the corner points mentioned in lines 1 and 2 above were in conformance with regulations and rules therefore as required in the current manual of survey instructions of the United States Department of the Interior, Bureau of Land Management or by a decree of a Court of Law and/or that the corner points mentioned in lines 3, 4 and 5 above were in conformance with the rules of the Michigan Board of Land Surveyors or by a Decree of a Court of Law, established, re-established, monumented, recovered, found as expressed below:

NOTE: Not more than 2 corners, all in the same town and range, may be recorded on this certificate.

A	B	C	D	E	F	G	H	I	J	K	L	M
1												
2	6		5		4		3		2		1	
3												
4	7		8		9		10		11		12	
5												
6	10		17		16		15		14		13	
7												
8	19		20		21		22		23		24	
9												
10	30		29		28		27		26		25	
11												
12	31		32		33		34		35		36	
13												

A. Description of original monument and accessories and/or subsequent restoration:

M-13	1831	GLO	Mullett	Set Post
	1941	Kent Co. Wit.		3/4" Iron
	1974	LCRC #722	VanKooten	3/4" Iron
	1978	LCRC #1137	VanKooten	3/4" Iron
	1981	LCRC #1695	Merdzinski	Set Kent County Monument
	1991	LCRC #6069	Unema	Kent County Monument

P.A. 345 1990 KENT COUNTY

PEER APPROVED 3/17/96

CHAIRMAN *Harry Huber*

The position of this corner was previously approved by the Kent County Remonumentation Peer Group, monumented by John A. Merdzinski on 2/20/81 and was recorded per LCRC #1695

B. Description of corner evidence found and/or method applied in restoring or reestablishing corner:

M-13 Found standard Kent Co. Mon. (Harrison) per witnesses from above LCRC as set by John A. Merdzinski in place of the 3/4" Iron over another 3/4" Iron he found. Both Irons check with Kent Co. Wit. and LCRC's #722, 1137.

LCRC #1695 (Nail/tag in trees-poles)	LCRC #6069
48" Oak N80°E 160.29'	PP N50°W 114.54'
40" Oak S70°E 104.23'	PP S60°W 98.36'
40" Oak S60°E 65.81'	PP N60°E 142.91'
Fc. Post S50°W 45.21'	
40" Oak N75°W 136.11'	same witnesses ±


The selected location is accepted by me and is generally accepted by professional surveyors as the best available evidence of the position of the original corner.

C. Description of monument for corner and accessories established to perpetuate locating the position of the corner:

M-13 Standard Kent County Monument

Nail & KC Remon. tag NW side	50" Oak N83°E	160.11'
Nail & KC Remon. tag N. side	40" Oak S71°E	104.16'
Nail & KC Remon. tag NE side	42" Oak S62°E	65.76'
Nail & KC Remon. tag S. side	41" Oak N70°W	136.00'
Nail & KC Remon. tag SE side	Fc. Post S50°W	45.35'
Nail & KC Remon. tag S. side	P. Pole N53°W	114.54'
Nail & KC Remon. tag S. side	P. Pole S74°W	98.30'
Nail & KC Remon. tag NW side	P. Pole N65°E	142.75'

C/L "X" Snow Ave. and 60th St. is South 1'±

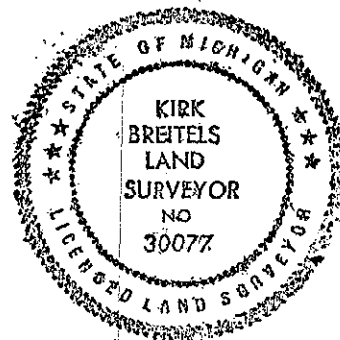

Signed by *Kirk Breitels*
Surveyor's Michigan License No. 30077

Date 3/1/96