

FEB 14 1997

COMMISSION


LAND CORNER RECORDATION CERTIFICATE
Filing Requirement of Act 74, Mich. P.A. 1970
KENT COUNTY REMONUMENTATION

For corners in

Table with columns: Kent (County), Located in: Caledonia Township, Corner Code #. Rows include Public Land Survey, Property Controlling in Section, and Miscellaneous Property in Sec.

STATE OF MICHIGAN COUNTY OF KENT RECEIVED FOR RECORD
96 NOV -8 AM 9:25
REG. OF DEEDS
9574
Register of Deeds Stamp & File Number

4. Lot No. _____, Recorded Plat _____
5. Private Claims _____

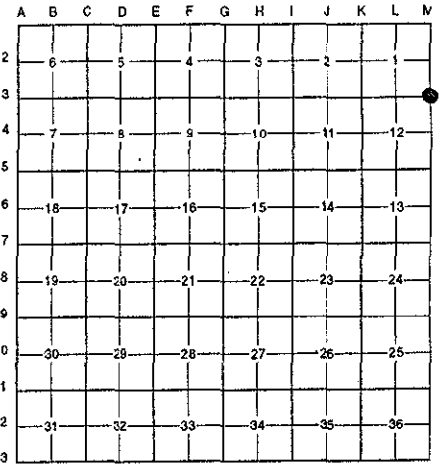

I, Randy Kolehouse, in a field survey on May 3, 1996, do hereby certify that under requirements of P.A. 74 Michigan P.A. of 1970, the corner points mentioned in lines 1 and 2 above were in conformance with regulations and rules therefore as required in the current manual of survey instructions of the United States Department of the interior, Bureau of Land Management or by a decree of a Court of Law and/or that the corner points mentioned in lines 3, 4 and 5 above were in conformance with the rules of the Michigan Board of Land Surveyors or by a Decree of a Court of Law; established, re-established, monumented, re-monumented, recovered, found as expressed below:

NOTE: Not more than 4 corners, all in the same town and range, may be recorded on this certificate.

A. Description of original monument and accessories and/or subsequent restoration:

Table with columns: Date, Description, Surveyor, Monument Type, and P.A. 345 1990 KENT COUNTY PEER APPROVED 8/22/96 CHAIRMAN Randy Kolehouse.

Note: This corner is common with A-3, T5N, R9W.

This corner was originally approved by the Kent County Remonumentation Peer Group and monumented by Rob Jonker on 11/23/82 and was recorded per L.C.R.C. #3186.

B. Description of corner evidence found and/or method applied in restoring or reestablishing corner:

M-3 Found a Standard Kent County Monument in the C/L intersection of 68th Street (bit.) running East and West and Snow Avenue (gravel) running North and South per L.C.R.C.'s #3186 and #8154 as set by Rob Jonker in place of a "T" iron at grade in a monument box over a 3/4" round iron 15" below grade which checked L.C.R.C.'s #3375, #968, #834 and the K.C. Surveyor's records.

L.C.R.C. #3186

L.C.R.C. #8154

Remon. tag on NE side t. pole N 50° W 115.75'
Remon. tag on SE side t. pole N 30° E 144.70'
Remon. tag on SW side p. pole S 45° E 85.88'
Remon. tag on E side 12" Pine S 20° W 105.93'
Remon. tag on N side 9" Tw. Oak S 70° W 114.5'
On C/L "X"


Nail & KC Remon. tag NE side T. Pole N 50° W 115.75'
Nail & KC Remon. tag SE side T. Pole N 30° E 144.70'
Nail & KC Remon. tag SW side P. Pole S 45° E 85.92'
Nail & KC Remon. tag E. side 18" Pine S 20° W 105.97'
Nail & KC Remon. tag N. side 14" Tw. Oak S 70° W 114.42'
On C/L "X"

The selected location is accepted by me and is generally accepted by professional surveyors as the best available evidence of the position of the original corner.

C. Description of monument for corner and accessories established to perpetuate locating the position of the corner:

M-3 Standard Kent County Monument

- Nail & K.C. remon. tag on NE side T. pole N 50° W 115.75'
Nail & K.C. remon. tag on SE side T. pole N 30° E 144.70'
Nail & K.C. remon. tag on SW side P. pole S 45° E 85.92'
Nail & K.C. remon. tag on E side 18" Pine S 20° W 105.97'
Nail & K.C. remon. tag on N side 14" Tw. Oak S 70° W 114.42'

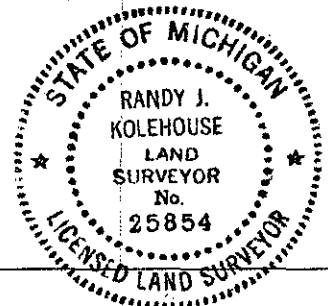

Signed by Randy J. Kolehouse EARTH TECH

Date 10/8/96

Surveyor's Michigan License No. 25854