

FEB 14 1997


LAND CORNER RECORDATION CERTIFICATE
Filing Requirement of Act 74, Mich. P.A. 1970
KENT COUNTY REMONUMENTATION

For corners in

Table with columns: Kent (County), Located in: Caledonia Township, Corner Code #. Rows include Public Land Survey, Property Controlling in Section, Miscellaneous Property in Sec.

STATE OF MICHIGAN
COUNTY OF KENT
RECEIVED FOR RECORD
96 NOV -8 AM 9:25
REG. OF DEEDS
9577
Register of Deeds Stamp & File Number

4. Lot No. , Recorded Plat
5. Private Claims

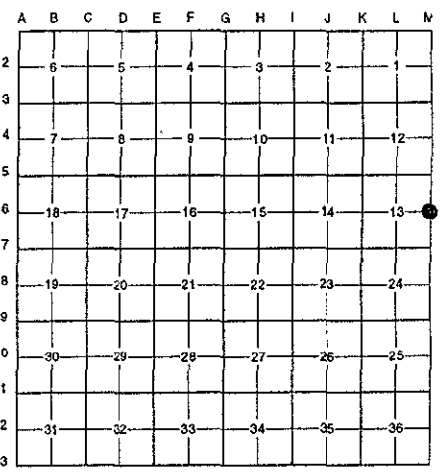

I, Randy Kolehouse, in a field survey on April 1 19 96, do hereby certify that under requirements of P.A. 74 Michigan P.A. of 1970, the corner points mentioned in lines 1 and 2 above were in conformance with regulations and rules therefore as required in the current manual of survey instructions of the United States Department of the interior, Bureau of Land Management or by a decree of a Court of Law and/or that the corner points mentioned in lines 3, 4 and 5 above were in conformance with the rules of the Michigan Board of Land Surveyors or by a Decree of a Court of Law; established, re-established, monumented, re-monumented, recovered, found as expressed below:

NOTE: Not more than 4 corners, all in the same town and range, may be recorded on this certificate.

A. Description of original monument and accessories and/or subsequent restoration:

Table with columns: M-6, 1817, G.L.O. Notes, L. Lyon, Set Post, 1966, Witness Map, K.C. Surveyor, "T" Iron, 1975, L.C.R.C. #844, Medema, Van Kooten & Assoc., Round Iron w/Cap #12029, 1976, L.C.R.C. #3375, D. Ankröm, Rebar and Cap, 1982, L.C.R.C. #3183, Jonker Land Survey, Fnd. 1" Pipe / Set K.C. Monument, 1995, L.C.R.C. #8157, K. Breiteis, K.C. Monument

Note: This corner is common with A-6, T5N, R9W.

This corner was originally approved by the Kent County Remonumentation Peer Group and monumented by Rob Jonker on 11/22/82 and was recorded per L.C.R.C. #3183.

B. Description of corner evidence found and/or method applied in restoring or reestablishing corner:

M-6 Found a Standard Kent County Monument in the C/L of Snow Avenue (gravel) running North and South on line of a fence line and a tree row running East and West per L.C.R.C.'s #3183 and #8157 as set by Rob Jonker in place of a 1" pipe he found which checked L.C.R.C.'s #3375, #844, and the K.C. Surveyor's records.

L.C.R.C. #3183

L.C.R.C. #8157

Remon. tag on NE side 14" Hickory S 50° E 33.72'
Remon. tag on N side Fe. cor. post West 26.95'
Remon. tag on SE side 12" Hickory S 25° W 58.95'


Nail & KC Remon. tag NE side 14" Hickory-stump S 50° E 33.72' (m. 33.67')
Nail & KC Remon. tag N. side fe. cor. post S 90° W 26.95'
Nail & KC Remon. tag E. side 18" Hickory S 25° W 58.30'
Nail & KC Remon. tag E. side 36" Cherry N 10° W 84.86' (m. 84.82')
Nail & KC Remon. tag N. side 12" Hickory N 80° E 21.10' (m. 21.04')
On E-W tree and fence lines

The selected location is accepted by me and is generally accepted by professional surveyors as the best available evidence of the position of the original corner.

C. Description of monument for corner and accessories established to perpetuate locating the position of the corner:

M-6 Standard Kent County Monument

Nail & K.C. remon. tag on NE side 14" Hickory (Stump) S 50° E 33.67'
Nail & K.C. remon. tag on N side fence cor. post S 90° W 26.95'
Nail & K.C. remon. tag on E side 18" Black Oak S 25° W 58.30'
Nail & K.C. remon. tag on E side 36" Cherry N 10° W 84.82'
Nail & K.C. remon. tag on N side 12" Hickory N 80° E 21.04'

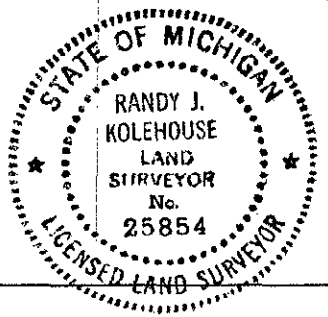

Signed by Randy J. Kolehouse

Date 10/8/96

Surveyor's Michigan License No. 25854

P.A. 345 1990 KENT COUNTY
PEER APPROVED 8/22/96
CHAIRMAN [Signature]