

\$7.00
\$2.00

FEB 14 1997

COMMISSION


LAND CORNER RECORDATION CERTIFICATE
Filing Requirement of Act 74, Mich. P.A. 1970
KENT COUNTY REMONUMENTATION

For corners in

Kent (County)	Located in: Caledonia Township	Corner Code #
1. Public Land Survey	T <u>5N</u> R <u>10W</u>	<u>M-8</u>
	T _____ R _____	_____
	T _____ R _____	_____
	T _____ R _____	_____
2. Property Controlling in Section	S _____ T _____ R _____	_____
	S _____ T _____ R _____	_____
3. Miscellaneous Property in Sec.	S _____ T _____ R _____	_____
	S _____ T _____ R _____	_____
4. Lot No. _____, Recorded Plat _____		
5. Private Claims _____		

STATE OF MICHIGAN
COUNTY OF KENT
RECEIVED FOR RECORD
96 NOV -8 AM 9:25
REG. OF DEEDS
Lucy Bond
9581
Register of Deeds Stamp & File Number

I, Randy Kolehouse, in a field survey on September 2 19 96, do hereby certify that under requirements of P.A. 74 Michigan P.A. of 1970, the corner points mentioned in lines 1 and 2 above were in conformance with regulations and rules therefore as required in the current manual of survey instructions of the United States Department of the interior, Bureau of Land Management or by a decree of a Court of Law and/or that the corner points mentioned in lines 3, 4 and 5 above were in conformance with the rules of the Michigan Board of Land Surveyors or by a Decree of a Court of Law; established, re-established, monumented, re-monumented, recovered, found as expressed below:

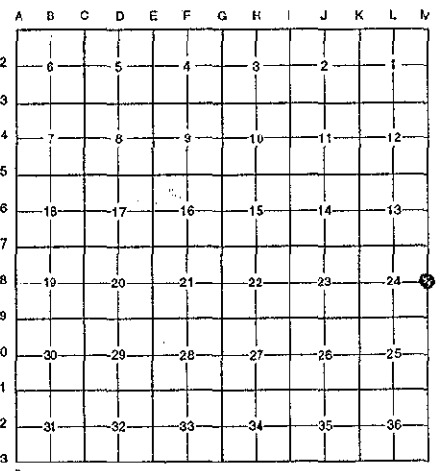

NOTE: Not more than 4 corners, all in the same town and range, may be recorded on this certificate.

A. Description of original monument and accessories and/or subsequent restoration:

M-8	1817	G.L.O. Notes	L. Lyon	Set Post
	1961	Witness Map	K.C. Surveyor	Iron
	1979	L.C.R.C. #1320	Exxel Engineering	Set Capped Iron Over 3/4" Round Iron
	1981	L.C.R.C. #1989	Jonker Land Surveys	Fnd. Capped Iron Over 3/4" Round Iron / Set K.C. Monument
	1995	L.C.R.C. #8161	K. Breitels	K.C. Monument

P.A. 345 1990 KENT COUNTY
PEER APPROVED 10/24/96
CHAIRMAN Harry Huber

Note: This corner is not common with A-8; T5N, R9W.

This corner was originally approved by the Kent County Remonumentation Peer Group and monumented by Rob Jonker on 8/10/81 and was recorded per L.C.R.C. #1989.

B. Description of corner evidence found and/or method applied in restoring or reestablishing corner:

M-8 Found a Standard Kent County Monument per L.C.R.C.'s #1989 and #8161 as set by Rob Jonker in place of a capped iron over a 3/4" round iron he found which checked L.C.R.C. #1320 and the K.C. Surveyor's records.

L.C.R.C. #1989

Remon. tag on N side 8" Maple N 81° E 18.49'
Remon. tag on N side 12" Elm S 60° E 10.99'
Remon. tag on W side 6" Basswood S 21° W 19.59'
iron N. 6.57'

L.C.R.C. #8161


Nail & KC Remon. tag N. side 8" dead Maple N 81° E 18.49' (m. 18.55')
Nail & KC Remon. tag N. side 12" Elm S 60° E 10.90' (m. 11.10')
Nail & KC Remon. tag W. side 6" Basswood S 21° W 19.70' (m. 19.85')
Nail & KC Remon. tag N. side 12" Elm N 65° E 14.74' (m. 14.75')
Nail & KC Remon. tag N. side Tw. 4" Maple N 75° W 15.27' (m. 15.10')
Kent Co. Mon. (A-8, T5N, R9W) N 00° E 6.60' (m. 6.30')

The selected location is accepted by me and is generally accepted by professional surveyors as the best available evidence of the position of the original corner.

C. Description of monument for corner and accessories established to perpetuate locating the position of the corner:

M-8 Standard Kent County Monument

Nail & K.C. remon. tag on N side 8" dead Maple N 81° E 18.55'
Nail & K.C. remon. tag on N side 12" Elm S 60° E 11.10'
Nail & K.C. remon. tag on W side 6" Basswood S 21° W 19.85'
Nail & K.C. remon. tag on N side 12" Elm N 65° E 14.75'
Nail & K.C. remon. tag on N side Tw. 4" Maple N 75° W 15.10'
Kent Co. Mon. (A-8, T5N, R9W) N 00° E 6.30'

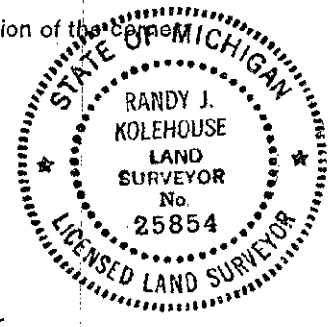

Signed by Randy J. Kolehouse Date 10/25/96
EARTH TECH

Surveyor's Michigan License No. 25854