

SURVEY & REMONUMENTATION

FEB 14 1997

COMMISSION LAND CORNER RECORDATION CERTIFICATE
Filing Requirement of Act 74, Mich. P.A. 1970

For corners in Kent KENT COUNTY REMONUMENTATION
 (County)

	Located in:	Caledonia Township	Corner Code #
1. Public Land Survey	T <u>5N</u> R <u>10W</u>		<u>M-10</u>
	T _____ R _____		_____
	T _____ R _____		_____
	T _____ R _____		_____
2. Property Controlling in Section	S _____ T _____ R _____		_____
	S _____ T _____ R _____		_____
3. Miscellaneous Property in Sec.	S _____ T _____ R _____		_____
	S _____ T _____ R _____		_____

STATE OF MICHIGAN
 COUNTY OF KENT
 RECEIVED FOR RECORD
 96 NOV -8 AM 9:25
 REG. OF DEEDS
 9583
 Register of Deeds Stamp & File Number

4. Lot No. _____, Recorded Plat _____
 5. Private Claims _____

I, Randy Kolehouse, in a field survey on May 6 19 96, do hereby certify that under requirements of P.A. 74 Michigan P.A. of 1970, the corner points mentioned in lines 1 and 2 above were in conformance with regulations and rules therefore as required in the current manual of survey instructions of the United States Department of the Interior, Bureau of Land Management or by a decree of a Court of Law and/or that the corner points mentioned in lines 3, 4 and 5 above were in conformance with the rules of the Michigan Board of Land Surveyors or by a Decree of a Court of Law; established, re-established, monumented, re-monumented, recovered, found as expressed below:

NOTE: Not more than 4 corners, all in the same town and range, may be recorded on this certificate.

A. Description of original monument and accessories and/or subsequent restoration:

M-10 1817	G.L.O. Notes	L. Lyon	Set Post
1983	L.C.R.C. #3721	All-Points Surveyors, Inc.	Set Capped Iron
1984	L.C.R.C. #3831	R. Kolehouse	Fnd. Capped Iron #17639 / Set K.C. Monument
1995	L.C.R.C. #8163	K. Breitels	K.C. Monument

Note: This corner is not common with A-10, T5N, R9W.

This corner was originally approved by the Kent County Remonumentation Peer Group and monumented by Randy Kolehouse on 3/31/84 and was recorded per L.C.R.C. #3831.

B. Description of corner evidence found and/or method applied in restoring or reestablishing corner:

M-10 Found a Standard Kent County Monument 5.0' ± North on line of a fence line running North, South, East and West per L.C.R.C.'s #3831 and #8163 as set by Randy Kolehouse in place of a capped iron #17639 he found 3.95' North of the West 1/4 corner of Section 30, T5N, R9W, which checked L.C.R.C. #3721.

L.C.R.C. #3831

L.C.R.C. #8163

Nail & K.C. Remon. tag in N. side 8" W. Cherry S 85° W 36.30'
 Nail & K.C. Remon. tag in N. side 14" W. Cherry S 60° E 7.37'
 Nail & K.C. Remon. tag in W. side 26" Oak S 05° E 12.32'
 Nail & K.C. Remon. tag in E. side 8" W. Cherry N 15° E 30.45'
 Corner of fences running N,S,E, & W is 5' m/l South


Nail & KC Remon. tag N. side 15" W. Cherry S 85° W 36.30'
 Nail & KC Remon. tag N. side 18" W. Cherry S 60° E 7.37'
 Nail & KC Remon. tag W. side 26" dead Oak S 05° E 12.32'
 Nail & KC Remon. tag E. side 12" W. Cherry N 15° W 30.46'
 Nail & KC Remon. tag W. side 6" Maple S 05° W 24.57'
 Kent Co. Mon. (A-10, T5N, R9W) S 00° E 3.95'
 Corner of fences running N, S, E, W is 5' m/l South

The selected location is accepted by me and is generally accepted by professional surveyors as the best available evidence of the position of the original corner.

C. Description of monument for corner and accessories established to perpetuate locating the position of the corner:

M-10 Standard Kent County Monument

Nail & K.C. remon. tag on N side 15" White Cherry S 85° W 36.30'
 Nail & K.C. remon. tag on N side 18" White Cherry S 60° E 7.37'
 Nail & K.C. remon. tag on W side 26" Dead Oak S 05° E 12.32'
 Nail & K.C. remon. tag on E side 12" White Cherry N 15° W 30.46'
 Nail & K.C. remon. tag on W side 6" Maple S 05° W 24.57'
 K.C. Mon. A-10, T5N, R9W, S 00° E 3.95'

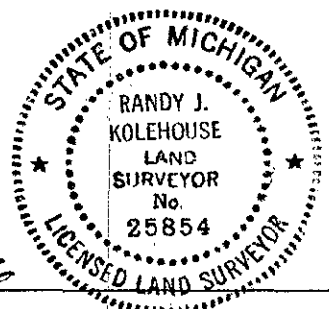

Signed by Randy J. Kolehouse Date 10/8/96

EARTH TECH

Surveyor's Michigan License No. 25854