

SURVEY & REMONUMENTATION

FEB 14 1997

COMMISSION

LAND CORNER RECORDATION CERTIFICATE
Filing Requirement of Act 74, Mich. P.A. 1970
KENT COUNTY REMONUMENTATION

For corners in

Kent
 (County)

Located in: Caledonia Township Corner Code #

1. Public Land Survey	T <u>5N</u>	R <u>10W</u>	<u>M-11</u>
	T _____	R _____	_____
	T _____	R _____	_____
	T _____	R _____	_____
2. Property Controlling in Section	S _____	T _____	R _____
	S _____	T _____	R _____
3. Miscellaneous Property in Sec.	S _____	T _____	R _____
	S _____	T _____	R _____

STATE OF MICHIGAN
 COUNTY OF KENT
 RECEIVED FOR RECORD

96 NOV -8 AM 9:25

REG. OF DEEDS

Lucy Bond

9584
 Register of Deeds Stamp & File Number

4. Lot No. _____, Recorded Plat _____
 5. Private Claims _____

I, Randy Kolehouse, in a field survey on April 9 19 96, do hereby certify that under requirements of P.A. 74 Michigan P.A. of 1970, the corner points mentioned in lines 1 and 2 above were in conformance with regulations and rules therefore as required in the current manual of survey instructions of the United States Department of the interior, Bureau of Land Management or by a decree of a Court of Law and/or that the corner points mentioned in lines 3, 4 and 5 above were in conformance with the rules of the Michigan Board of Land Surveyors or by a Decree of a Court of Law; established, re-established, monumented, re-monumented, recovered, found as expressed below:

NOTE: Not more than 4 corners, all in the same town and range, may be recorded on this certificate.

A	B	C	D	E	F	G	H	I	J	K	L	M
2	6	5	4	3	2	1						
3												
4	7	8	9	10	11	12						
5												
6	18	17	16	15	14	13						
7												
8	19	20	21	22	23	24						
9												
10	30	29	28	27	26	25						
11												
12	31	32	33	34	35	36						
13												

A. Description of original monument and accessories and/or subsequent restoration:

M-11 1817	G.L.O. Notes	L. Lyon	Set Post
1966	Witness Map	K.C. Surveyor	1/2" Iron
1981	L.C.R.C. #1835	Exxel Engineering	Capped Iron
1981	L.C.R.C. #2682	Jonker Land Survey	Fnd. Exxel Capped Iron / Set K.C. Monument
1995	L.C.R.C. #8164	K. Breitels	K.C. Monument

P.A. 345 1990 KENT COUNTY
 PEER APPROVED 8/22/96
 CHAIRMAN *Hans Huber*

Note: This corner is not common with A-11, T5N, R9W.

This corner was originally approved by the Kent County Remonumentation Peer Group and monumented by Rob Jonker on 8/14/81 and was recorded per L.C.R.C. #2682.

B. Description of corner evidence found and/or method applied in restoring or reestablishing corner:

M-11 Found a Standard Kent County Monument 14' North of the C/L of 100th Street (bit.) running East and West on possession lines North and South per L.C.R.C.'s #2682 and #1835 as set by Rob Jonker in place of an Exxel capped iron he found over a 3/4" round iron 24" below grade which checked L.C.R.C. #1835 and the K.C. Surveyor's records.

L.C.R.C. #2682

Iron in mon. box on C/L, South 14.50'
 Remon. tag on E side p. pole North 26.49'
 Remon. tag on SE side 8" Elm N 39° E 19.79'

L.C.R.C. #8164


Kent Co. Mon. in mon. box (A-11, T5N, R9W) S 00° E 14.49'
 Nail & KC Remon. tag E. side P. Pole N 00° E 26.51'
 Nail & KC Remon. tag SE side 12" Elm N 39° E 19.85'
 Nail & KC Remon. tag W. side 12" Ash S 15° E 46.18'
 On line possession lines N & S

The selected location is accepted by me and is generally accepted by professional surveyors as the best available evidence of the position of the original corner.

C. Description of monument for corner and accessories established to perpetuate locating the position of the corner:

M-11 Standard Kent County Monument

K.C. Mon. in monument box, A-11, T6N, R9W, on C/L bit. S 00° E 14.49'
 Nail & K.C. remon. tag on E side P. pole N 00° E 26.5'
 Nail & K.C. remon. tag on SE side 12" Elm N 39° E 19.85'
 Nail & K.C. remon. tag on W side 12" Ash S 15° E 46.18'
 North edge bit. 2' South

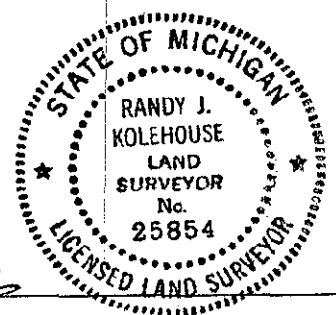

Signed by *Randy J. Kolehouse* Date 10/8/96

Surveyor's Michigan License No. 25854