

FEB 14 1997

COMMISSION

LAND CORNER RECORDATION CERTIFICATE
Filing Requirement of Act 74, Mich. P.A. 1970
KENT COUNTY REMONUMENTATION

For corners in

Table with columns: Kent (County), Located in: Caledonia Township, Corner Code #. Rows include Public Land Survey, Property Controlling in Section, Miscellaneous Property in Sec.

STATE OF MICHIGAN
COUNTY OF KENT
RECEIVED FOR RECORD
96 NOV -8 AM 9:26
REG. OF DEEDS
9585
Register of Deeds Stamp & File Number

4. Lot No. , Recorded Plat
5. Private Claims

I, Randy Kolehouse, in a field survey on May 6 19 96, do hereby certify that under requirements of P.A. 74 Michigan P.A. of 1970, the corner points mentioned in lines 1 and 2 above were in conformance with regulations and rules therefore as required in the current manual of survey instructions of the United States Department of the interior, Bureau of Land Management or by a decree of a Court of Law and/or that the corner points mentioned in lines 3, 4 and 5 above were in conformance with the rules of the Michigan Board of Land Surveyors or by a Decree of a Court of Law; established, re-established, monumented, re-monumented, recovered, found as expressed below:

Grid table with columns A-N and rows 2-13. Cell (12, N) contains a black dot.

NOTE: Not more than 4 corners, all in the same town and range, may be recorded on this certificate.

A. Description of original monument and accessories and/or subsequent restoration:

Table with columns: M-12, G.L.O. Notes, L. Lyon, Set Post, P.A. 345 1990 KENT COUNTY PEER APPROVED, CHAIRMAN.

Note: This corner is common with A-12, T5N, R9W.

This corner was originally approved by the Kent County Remonumentation Peer Group and monumented by Randy Kolehouse on 3/31/84 and was recorded per L.C.R.C. #3989.

B. Description of corner evidence found and/or method applied in restoring or reestablishing corner:

M-12 Found a Standard Kent County Monument on line of fence running North-South-East and meandering fence West per L.C.R.C.'s #3989 and #8165 as set by Randy Kolehouse in place of a 3/4" iron he found which checked L.C.R.C. #1346 and the K.C. Surveyor's records.

L.C.R.C. #3989

L.C.R.C. #8165

Nail & K.C. Remon. tag in W. side 22" Ash N. 2.1'
Nail & K.C. Remon. tag in W. side twin 18" Ash S. 11.85'
Nail & K.C. Remon. tag in N. side twin 8" Maple W. 18.0'
Nail & K.C. Remon. tag in S. side 18" Ash S 50 W 44.85'
Nail & K.C. Remon. tag in SW side 8" Ash S 50 E 36.7'
On line of fences N. S. E. & meandering fe, West


Nail & KC Remon. tag W. side 22" Ash N 00° E 2.13'
Nail & KC Remon. tag W. side Twin 22" Ash S 00° E 11.79'
Nail & KC Remon. tag N. side Twin 12" Maple S 90° W 18.06'
Nail & KC Remon. tag S. side 24" Ash S 50° W 44.87'
Nail & KC Remon. tag SW side 10" Ash S 50° E 36.72'
Nail & KC Remon. tag E. side Twin 18" Maple N 25° W 25.63'
On line of fences N, S, E & meandering fence West

The selected location is accepted by me and is generally accepted by professional surveyors as the best available evidence of the position of the original corner.

C. Description of monument for corner and accessories established to perpetuate locating the position of the corner:

M-12 Standard Kent County Monument

Nail & K.C. remon. tag on West side 22" Ash N 0° E 2.13'
Nail & K.C. remon. tag on W side 22" Ash S 00° E 11.79'
Nail & K.C. remon. tag on N side Twin 12" Maple S 90° W 18.06'
Nail & K.C. remon. tag on S side 24" Ash S 50° W 44.87'
Nail & K.C. remon. tag on SW side 10" Ash S 50° E 36.72'
Nail & K.C. remon. tag on E side Twin 18" Maple N 25° W 25.63'

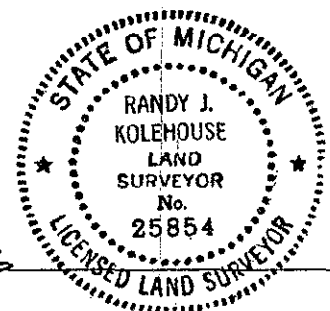

Signed by Randy J. Kolehouse Date 10/9/96

Surveyor's Michigan License No. 25854