SURVEY & REMONUMENTATION

$7.00
$2.00

FEB 1 4 1997

COMMISSION

LAND CORNER RECORDATION CERTIFICATE

Filing Requirement of Act 74, Mich. P.A. 1970

KENT COUNTY REMONUMENTATION

For corners in Kent (County) Located in: Caledonia Township Corner Code #

STATE OF MICHIGAN
COUNTY OF KENT
RECEIVED FOR RECORD
96 NOV -8 AM 9:26
REG. OF DEEDS
9586

Register of Deeds Stamp & File Number

1. Public Land Survey		T 5N	R 10W	M-13
		T	R	
		T	R	
		T	R	Seq. #1
2. Property Controlling in Section	S	T	R	
	S	T	R	
3. Miscellaneous Property in Sec.	S	T	R	
	S	T	R	

4. Lot No._____, Recorded Plat _____
5. Private Claims _____

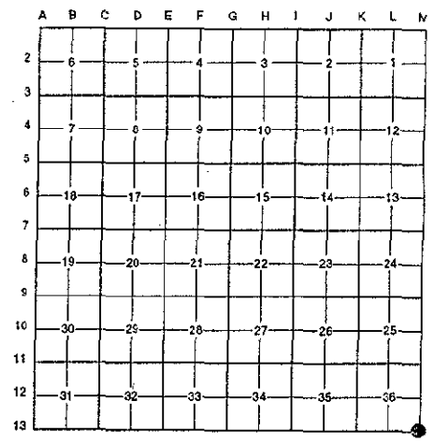

I, Randy Kolehouse, in a field survey on April 10 19 96, do hereby certify that under requirements of P.A. 74 Michigan P.A. of 1970, the corner points mentioned in lines 1 and 2 above were in conformance with regulations and rules therefore as required in the current manual of survey instructions of the United States Department of the interior, Bureau of Land Management or by a decree of a Court of Law and/or that the corner points mentioned in lines 3, 4 and 5 above were in conformance with the rules of the Michigan Board of Land Surveyors or by a Decree of a Court of Law; established, re-established, monumented, re-monumented, recovered, found as expressed below:

NOTE: Not more than 4 corners, all in the same town and range, may be recorded on this certificate.

A. Description of original monument and accessories and/or subsequent restoration:

M-13	1817	G.L.O. Notes	L. Lyon	Set Post
	1973	Witness Map	K.C. Surveyor	"T" Iron
	1973	L.C.R.C. #410	Medema, Van Kooten & Assoc.	"T" Iron
	1981	L.C.R.C. #1711	Williams & Works	Fnd. "T" Iron / Set K.C. Monument

Note: This corner is common with A-13, T5N, R9W, A-1, T4N, R9W and M-1, T4N, R10W.

This corner was originally approved by the Kent County Remonumentation Peer Group and monumented by Williams & Works on 2/19/81 and was recorded per L.C.R.C. #1711.

B. Description of corner evidence found and/or method applied in restoring or reestablishing corner:

M-13 Found a Standard Kent County Monument in the C/L of 108th Street running East and West on line of a fence line running North per L.C.R.C.'s #1711 as set by Williams & Works in place of a "T" iron they found which checked L.C.R.C. #410 and the K.C. Surveyor's records. Witnesses indicated in L.C.R.C.'s #410 and #1711 no longer exist.

P.A. 345 1990 KENT COUNTY
PEER APPROVED 8/22/96
CHAIRMAN Harry Huber

The selected location is accepted by me and is generally accepted by professional surveyors as the best available evidence of the position of the original corner.

C. Description of monument for corner and accessories established to perpetuate locating the position of the corner:

M-13 Standard Kent County Monument

Nail & K.C. remon. tag on NE side P. pole 5' above ground S 55° E 63.36'
Nail & K.C. remon. tag on S side 14" Hickory 6' above ground N 70° E 150.41'
Nail & K.C. remon. tag on NE side 8" Elm 7' above ground N 26° W 42.13'
Nail & K.C. remon. tag on E side P. pole 7' above ground N 05° W 69.03'

STATE OF MICHIGAN
RANDY J. KOLEHOUSE
LAND SURVEYOR
No. 25854
LICENSED LAND SURVEYOR

Signed by Randy J. Kolehouse Date 10/8/96
EARTH TECH
Surveyor's Michigan License No. 25854

FORM APPROVED BY MICHIGAN STATE BOARD OF LAND SURVEYORS, JAN. 28, 1971
REVISED MAY 14, 1975
REVISED JAN., 1983