

KENT COUNTY REMONUMENTATION

LAND CORNER RECORDATION CERTIFICATE
Filing Requirement of Act 74, Mich. P.A. 1970

For corners in
KENT COUNTY
(County)

Located In: _____ Corner Code # _____

1. Public Land Survey	T <u>5N</u> R <u>9W</u>	<u>A-13</u>
	T <u>5N</u> R <u>10W</u>	<u>M-13</u>
	T _____ R _____	
	T _____ R _____	<u>Seg #2</u>
2. Property Controlling in Section	S _____ T _____ R _____	
	S _____ T _____ R _____	
3. Miscellaneous Property in Sec.	S _____ T _____ R _____	
	S _____ T _____ R _____	

STATE OF MICHIGAN
COUNTY OF KENT
RECEIVED FOR RECORD
97 APR 29 AM 8:17
REG. OF DEEDS
Lucy Stand

9704

Register of Deeds Stamp & File Number

4. Lot No. _____, Recorded Plat _____
5. Private Claims _____

A	B	C	D	E	F	G	H	I	J	K	L	M
1												
2	6		5		4		3		2		1	
3												
4	7		8		9		10		11		12	
5												
6	10		17		16		15		14		13	
7												
8	19		20		21		22		23		24	
9												
10	30		29		28		27		26		25	
11												
12	31		32		33		34		35		36	
13												

Kirk Breitels, in a field survey on Jan. 27, 1997 do hereby state that under requirements of P.A. 74, Michigan P.A. of 1970, the corner points mentioned in lines 1 and 2 above were in conformance with regulations and rules therefore as required in the current manual of survey instructions of the United States Department of the Interior, Bureau of Land Management or by a decree of a Court of Law and/or that the corner points mentioned in lines 3, 4 and 5 above were in conformance with the rules of the Michigan Board of Land Surveyors or by a Decree of a Court of Law; established, re-established, monumented, recovered, found as expressed below:

NOTE: Not more than 2 corners, all in the same town and range, may be recorded on this certificate.

A. Description of original monument and accessories and/or subsequent restoration:

A-13	1830	GLO	Mullett	Set Post
		Kent Co. Wit.		"T" Iron
	1973	LCRC #410	VanKooten	"T" Iron
	1981	LCRC #1711	Merdzinski	Set Kent County Monument
	1996	LCRC #9586	Kolehouse	Kent County Monument
	1996	LCRC #9606	Jonker	Reset Kent Co. Mon. after const.

The position of this corner was previously approved by the Kent County Remonumentation Peer Group, monumented by John A. Merdzinski on 2/19/81 and was recorded per LCRC #1711

B. Description of corner evidence found and/or method applied in restoring or reestablishing corner:

A-13 Found standard Kent Co. Mon. (Harrison) per wit. of above LCRC's, set by John A. Merdzinski in place of a "T" Iron he found. "T" Iron checks Kent Co. Wit. & LCRC #410.
LCRC #1711
LCRC #9606


Nail & tag 8" Elm	N35°W	27.03'	Nail & tag P. Pole	N05°W	69.03'
Nail & tag 8" Elm	N55°E	37.49'	Nail & tag 8" Ash	N27°W	42.17'
Nail & tag 6" Poplar	N70°E	94.57'	Nail & tag P. Pole	S56°E	63.38'
Nail & tag 8" Ash	S65°E	62.77'	Nail & tag 3" Ash	S28°W	57.20'
Nail & tag 6" Elm	S42°W	27.30'	EJG capped Iron	S04°W	32.85'
"X" on bolt 36" Culv.	S45°E	29.28'			

The selected location is accepted by me and is generally accepted by professional surveyors as the best available evidence of the position of the original corner.

C. Description of monument for corner and accessories established to perpetuate locating the position of the corner:

A-13 Standard Kent County Monument

Nail & KC Remon. tag E. side P. Pole	N05°W	69.03'
Nail & KC Remon. tag E. side 8" Elm	N27°W	42.17'
Nail & KC Remon. tag NE side P. Pole	S56°E	63.38'
Nail & KC Remon. tag W. side 3" Elm	S28°W	57.20'
Capped Iron - EJG	S04°W	32.85'

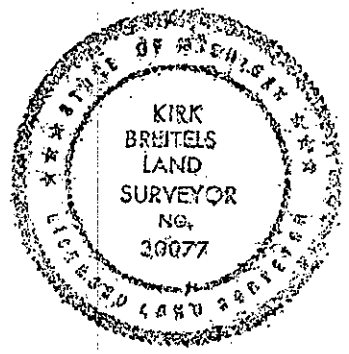

Signed by *Kirk Breitels*
Surveyor's Michigan License No. 30077

Date 3/27/97

P.A. 345 1990 KENT COUNTY
PEER APPROVED 3/27/97
CHAIRMAN *Harry Hubert*