

SURVEY & REMONUMENTATION

FEB 14 1997

LAND CORNER RECORDATION CERTIFICATE
COMMISSION Filing Requirement of Act 74, Mich. P.A. 1970
KENT COUNTY REMONUMENTATION

For corners in

Kent (County)	Located in: Gains Township	Corner Code #
1 Public Land Survey	T <u>5N</u> R <u>11W</u>	<u>A-2</u>
	T _____ R _____	_____
	T _____ R _____	_____
	T _____ R _____	_____
2 Property Controlling in Section	S _____ T _____ R _____	_____
	S _____ T _____ R _____	_____
3 Miscellaneous Property in Sec.	S _____ T _____ R _____	_____
	S _____ T _____ R _____	_____

REG. OF DEEDS

Handwritten signature

96 AUG - 8 AM 8:37

STATE OF MICHIGAN
COUNTY OF KENT
RECEIVED FOR RECORD

9202
Register of Deeds Stamp & File Number

4 Lot No. _____, Recorded Plat _____
 5 Private Claims _____

I, Randy Kolehouse, in a field survey on January 5 19 96, do hereby certify that under requirements of P.A. 74 Michigan P.A. of 1970, the corner points mentioned in lines 1 and 2 above were in conformance with regulations and rules therefore as required in the current manual of survey instructions of the United States Department of the interior, Bureau of Land Management or by a decree of a Court of Law and/or that the corner points mentioned in lines 3, 4 and 5 above were in conformance with the rules of the Michigan Board of Land Surveyors or by a Decree of a Court of Law; established, re-established, monumented, re-monumented, recovered, found as expressed below:

A	B	C	D	E	F	G	H	I	J	K	L	M
20	6	5	4	3	2	1						
3												
4	7	8	9	10	11	12						
5												
6	15	17	16	15	14	13						
7												
8	19	20	21	22	23	24						
9												
10	30	29	28	27	26	25						
11												
12	31	32	33	34	35	36						
13												

NOTE: Not more than 4 corners, all in the same town and range, may be recorded on this certificate.

A Description of original monument and accessories and/or subsequent restoration:

A-2 This corner was not originally set by the G.L.O.

N/A	Wit. Map	K.C. Surveyor	Stake C/L Pavement
1972	L.C.R.C. #210	Exxel Engineering	Found 1" Iron in Mon. Box
1973	L.C.R.C. #645	Medema, Van Kooten & Assoc.	Found 1" Iron in Mon. Box
1981	L.C.R.C. #1612	Exxel Engineering	Found 1" Iron in Mon. Box/Set K.C. Monument
1991	L.C.R.C. #6362	Chris Marschall	K.C. Monument

Note: This corner is common with M-2, T5N, R12W.

This corner was originally approved by the Kent County Remonumentation Peer Group and monumented by Exxel Engineering on 1/30/81 and was recorded per L.C.R.C. #1612.

B Description of corner evidence found and/or method applied in restoring or reestablishing corner:


A-2 Found standard Kent County Monument in the C/L of Division Avenue running N-S and 150' M/L North of Carriage Lane running West per L.C.R.C. #210 and #6362 as set by Exxel Engineering in place of a 1" iron in monument box they found which checked L.C.R.C.'s #210 and #645.

L.C.R.C. #210	L.C.R.C. #6362
Nail in N side P. Pole W 26.89'	Nail & Tag S. sd U.P. N 85 W 26.70'
Nail in S side T. Pole ESE 49.51'	SE corner Bldg. #6375 on brick S 70 W 113.45'
	Nail & Tag N. sd U.P. N 90 E 42.89'
	Centerline top nut hydrant S 45 W 96.76'
	SW corner Bldg. #6364 brick N 60 E 124.46'

The selected location is accepted by me and is generally accepted by professional surveyors as the best available evidence of the position of the original corner.

C Description of monument for corner and accessories established to perpetuate locating the position of the corner:

A-2 Standard Kent County Monument
 Nail & K.C. remon. tag on S side Utl. pole N 80° W 26.70'
 Nail & K.C. remon. tag on N side Utl. pole N 83° E 42.92'
 SE cor. bldg. #6375 on brick S 80° W 113.40'
 SW cor. bldg. #6364 on brick N 73° E 124.46'
 C/L top nut on hydrant S 42° W 96.74'

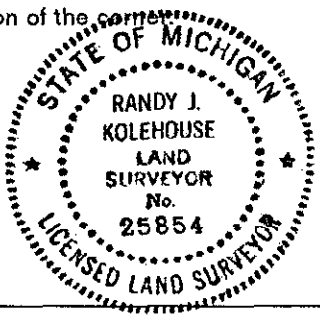

Signed by Randy J. Kolehouse
 EARTH TECH

Date 7/23/96

Surveyor's Michigan License No. 25854