

**SURVEY & REMONUMENTATION**

FEB 14 1997

**COMMISSION LAND CORNER RECORDATION CERTIFICATE**  
**Filing Requirement of Act 74, Mich. P.A. 1970**  
**KENT COUNTY REMONUMENTATION**

For corners in

Kent (County)	Located in:	Gaines Township	Corner Code #
Public Land Survey	T <u>5N</u>	R <u>11W</u>	<u>A-3</u>
	T _____	R _____	_____
	T _____	R _____	_____
	T _____	R _____	_____
2. Property Controlling in Section	S _____	T _____	R _____
	S _____	T _____	R _____
3. Miscellaneous Property in Sec.	S _____	T _____	R _____
	S _____	T _____	R _____

REG. OF DEEDS

*L. J. Kolehose*

STATE OF MICHIGAN  
 COUNTY OF KENT  
 RECEIVED FOR RECORD  
 96 AUG -8 AM 8:37

**9203**

Register of Deeds Stamp & File Number

4. Lot No. \_\_\_\_\_, Recorded Plat \_\_\_\_\_  
 5. Private Claims \_\_\_\_\_


Randy Kolehose, in a field survey on January 5 19 96, do hereby certify that under requirements of P.A. 74 Michigan P.A. of 1970, the corner points mentioned in lines 1 and 2 above were in conformance with regulations and rules therefore as required in the current manual of survey instructions of the United States Department of the interior, Bureau of Land Management or by a decree of a Court of Law and/or that the corner points mentioned in lines 3, 4 and 5 above were in conformance with the rules of the Michigan Board of Land Surveyors or by a Decree of a Court of Law; established, re-established, monumented, re-monumented, recovered, found as expressed below:

**NOTE: Not more than 4 corners, all in the same town and range, may be recorded on this certificate.**

**A. Description of original monument and accessories and/or subsequent restoration:**

A-3	1817	G.L.O. Notes	L. Lyon	Set Post
	1965	Wit. Map	K.C. Surveyor	Iron
	1972	L.C.R.C. #210	Exxel Engineering	Found 1/2" Iron Pipe
	1981	L.C.R.C. #1613	Exxel Engineering	Found 1 1/2" Iron in B.T./Set K.C. Monument
	1984	L.C.R.C. #3968	Exxel Engineering	K.C. Monument
	1991	L.C.R.C. #6363	Chris Marschall	K.C. Monument

P.A. 345 1990 KENT COUNTY  
 PEER APPROVED 3/7/96  
 CHAIRMAN *Randy Kolehose*

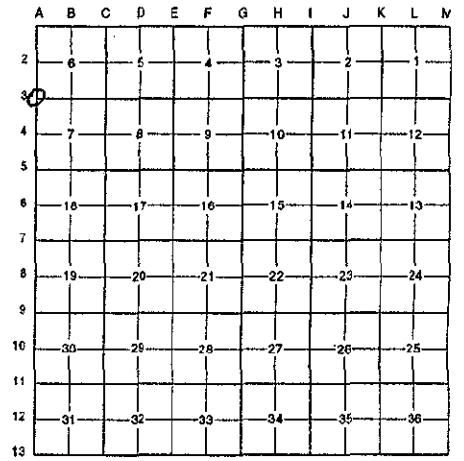

Note: This corner is common with M-13, T5N, R12W.

This corner was originally approved by the Kent County Remonumentation Peer Group and monumented by Exxel Engineering on 1/30/81 and was recorded per L.C.R.C. #1613.

**B. Description of corner evidence found and/or method applied in restoring or reestablishing corner:**

A-3 Found standard Kent County Monument at C/L intersection of Division Avenue running N-S and 68th Street running E-W per L.C.R.C.'s #1613 and #6363 as set by Exxel Engineering in place of 1 1/2" and 1" iron they found which checked L.C.R.C. #210 and K.C.R.C. Wit. Map.

<p>L.C.R.C. #1613</p> <p>C/L top of hydrant N 30°W 80.04'</p>	<p>L.C.R.C. #6363</p> <p>Centerline top of Hyd. N 30 W 79.98'</p> <p>Nail &amp; Tag SE Sd. U.P. S 35 W 59.99'</p> <p>Westerly corner Pine Rest sign (Brick) 1.5' above grd. S 30 E 86.75'</p> <p>Nail &amp; Tag NE Sd. Guy Pole S 80 E 89.62'</p>
---	---

The selected location is accepted by me and is generally accepted by professional surveyors as the best available evidence of the position of the original corner.

**C. Description of monument for corner and accessories established to perpetuate locating the position of the corner:**

A-3 Standard Kent County Monument

C/L top nut hydrant N 16° W 80.00'

Nail & K.C. remon. tag on SE side Utl. pole S 43° W 59.97'

Westerly top cor. Pine Rest sign (brick) (2' above ground) S 30° E 86.82'

Nail & K.C. remon. tag on NE side guy pole S 70° E 89.60'

C/L South nut to 12" dia. steel sign post N 55° E 79.71'

Signed by *Randy J. Kolehose*  
 EARTH TECH

Date 7/23/96

Surveyor's Michigan License No. 25854

