

SURVEY & REMONUMENTATION

FEB 14 1997

COMMISSION

LAND CORNER RECORDATION CERTIFICATE
Filing Requirement of Act 74, Mich. P.A. 1970
KENT COUNTY REMONUMENTATION

STATE OF MICHIGAN
 COUNTY OF KENT
 RECEIVED FOR RECORD

REG. OF DEEDS

Handwritten signature

96 AUG -8 AM 8:37

9205

Register of Deeds Stamp & File Number

For corners in

Kent (County)	Located in:	Gaines Township	Corner Code #
1. Public Land Survey	T <u>5N</u>	R <u>11W</u>	<u>A-5</u>
	T _____	R _____	_____
	T _____	R _____	_____
	T _____	R _____	_____
2. Property Controlling in Section	S _____	T _____	R _____
	S _____	T _____	R _____
3. Miscellaneous Property in Sec.	S _____	T _____	R _____
	S _____	T _____	R _____

4. Lot No. _____, Recorded Plat _____
 5. Private Claims _____

Randy Kolehouse, in a field survey on January 5 19 96, do hereby certify that under requirements of P.A. 74 Michigan P.A. of 1970, the corner points mentioned in lines 1 and 2 above were in conformance with regulations and rules therefore as required in the current manual of survey instructions of the United States Department of the interior, Bureau of Land Management or by a decree of a Court of Law and/or that the corner points mentioned in lines 3, 4 and 5 above were in conformance with the rules of the Michigan Board of Land Surveyors or by a Decree of a Court of Law; established, re-established, monumented, re-monumented, recovered, found as expressed below:

NOTE: Not more than 4 corners, all in the same town and range, may be recorded on this certificate.

A. Description of original monument and accessories and/or subsequent restoration:

A-5	1831	G.L.O. Notes	Mullett	Set Post
	1962	Witness Map	K.C. Surveyor	Boat Spike
	1973	L.C.R.C. #477	Williams & Works	Found 1" Iron in Mon. Box
	1980	L.C.R.C. #1528	Exxel Engineering	Found 1" Iron in Mon. Box/Set K.C. Monument
	1991	L.C.R.C. #6365	Chris Marschall	K.C. Monument

Note: This corner is common with M-5, T5N, R12W.

This corner was originally approved by the Kent County Remonumentation Peer Group and monumented by Exxel Engineering on 12/4/80 and was recorded per L.C.R.C. #1528.

B. Description of corner evidence found and/or method applied in restoring or reestablishing corner:

A-5 Found standard Kent County Monument at the C/L intersection of Division Avenue running N-S and 76th Street running E-W per L.C.R.C.'s #1528 and #6365 as set by Exxel Engineering in place of 1" iron in monument box they found when checked L.C.R.C. #477 and K.C. Surveyor's records.

L.C.R.C. #1528

L.C.R.C. #6365

SE corner brick gas station N50°W 82.22'
 Most N'y corner of 1' x 1' brick pillar of gas station
 S 45°W 124.11'

SE Cor brick gas station N 50 W 82.16'
 Nail & Tag U.P. NW side S 40 W 58.61'
 Nail & Tag U.P. N side N 50 E 64.15'
 N. Cor 1' x 1' Brick Pillar of gas station S 45 W 124.05'

The selected location is accepted by me and is generally accepted by professional surveyors as the best available evidence of the position of the original corner.

C. Description of monument for corner and accessories established to perpetuate locating the position of the corner:


A-5 Standard Kent County Monument

North cor. of 1' x 1' brick pillar at N cor. bldg. #7609 S 45° W 124.05'
 SE cor. brick bldg. #7585 N 50° W 82.20'
 Nail & K.C. remon. tag on SW side Guy pole N 20° W 60.16'
 Nail & K.C. remon. tag on NW side P. pole N 50° E 64.13'
 Nail & K.C. remon. tag on NW side P. pole S 40° W 58.59'
 Nail & K.C. remon. tag on SW side P. pole S 40° E 67.39'

Signed by Randy J. Kolehouse
 EARTH TECH

Date 7/23/96

Surveyor's Michigan License No. 25854

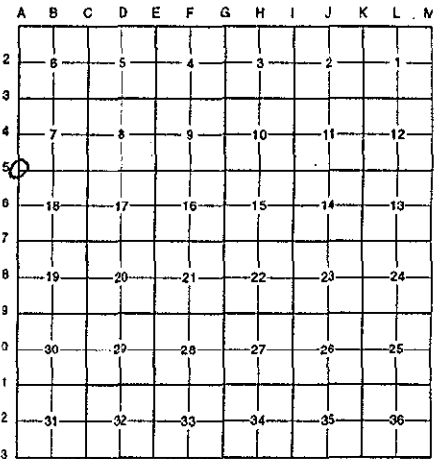

P.A. 345 1990 KENT COUNTY

PEER APPROVED 3/7/96
 CHAIRMAN Randy Kolehouse

