

SURVEY & REMONUMENTATION

FEB 14 1997

COMMISSION

LAND CORNER RECORDATION CERTIFICATE
Filing Requirement of Act 74, Mich. P.A. 1970
KENT COUNTY REMONUMENTATION

For corners in

	Kent (County)	Located in:	Gaines Township	Corner Code #
1	Public Land Survey	T <u>5N</u>	R <u>11W</u>	<u>A-9</u>
		T _____	R _____	_____
		T _____	R _____	_____
		T _____	R _____	_____
2	Property Controlling in Section	S _____	T _____	R _____
		S _____	T _____	R _____
3	Miscellaneous Property in Sec.	S _____	T _____	R _____
		S _____	T _____	R _____

REG. OF DEEDS

Handwritten signature

STATE OF MICHIGAN
 COUNTY OF KENT
 RECEIVED FOR RECORD
 96 AUG -8 AM 8:38


9209

Register of Deeds Stamp & File Number

4 Lot No. _____, Recorded Plat _____
 5 Private Claims _____

Randy Kolehouse, in a field survey on January 18 19 96,
 do hereby certify that under requirements of P.A. 74 Michigan P.A. of 1970, the corner points mentioned
 in lines 1 and 2 above were in conformance with regulations and rules therefore as required in the
 current manual of survey instructions of the United States Department of the interior, Bureau of Land
 Management or by a decree of a Court of Law and/or that the corner points mentioned in lines 3, 4 and 5
 above were in conformance with the rules of the Michigan Board of Land Surveyors or by a Decree of a
 Court of Law; established, re-established, monumented, re-monumented, recovered, found as
 expressed below:

NOTE: Not more than 4 corners, all in the same town and range, may be recorded
 on this certificate.

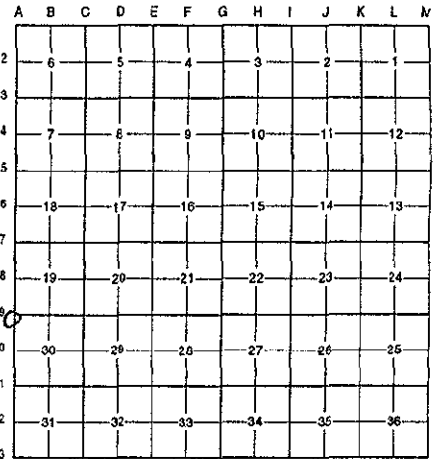

A Description of original monument and accessories and/or subsequent restoration:

A-9	1831	G.L.O. Notes	Mullett	Set Post	P.A. 345 1990 KENT COUNTY PEER APPROVED 3/7/96 CHAIRMAN <i>Handwritten signature</i>
	1905-71	Survey Records	Williams & Works	Stone	
	1960	Witness Map	K.C. Surveyor	Iron	
	1972	L.C.R.C. #359	Exxel Engineering	"T" Iron	
	1983	L.C.R.C. #3518	William Byl	Fnd. "T" Iron / Set K.C. Monument	
	1991	L.C.R.C. #6423	Chris Marschall	K.C. Monument	

Note: This corner is not common with M-9, T5N, R12W.

This corner was originally approved by the Kent County Remonumentation Peer Group and monumented by William Byl on
 9/28/83 and was recorded per L.C.R.C. #3518.

B Description of corner evidence found and/or method applied in restoring or reestablishing corner:

A-9 Found a Standard Kent County Monument on the C/L of Division Avenue running N-S, 10' ± South of the C/L of 92nd Street
 running E-W 10.59' South of M-9, T5N, R12W, as set by William Byl in place of a 24" "T" iron which he found that checked
 L.C.R.C. #359 and the K.C. Surveyor's records.

L.C.R.C. #3518

L.C.R.C. #6423

Nail & tag, W sd. 12" Hickory (Ash) S 05° W 33.17'

Nail & tag, W sd. 24" Maple N 05 W 69.90'

NE cor. Sec. 25, 5-12, (Kent County Monument) N 00 W 10.59'

Nail & Tag NW sd. U.P. N 40 E 45.41' (m. 45.63')

Nail & Tag N sd. 18" Maple N 55 W 55.02'

Nail & Tag W sd. 26" Maple N 05 W 69.91' (m. 70.01')

Nail & Tag S sd. 8" Maple S 55 E 42.97'

SE cor. Sec. 24 T5N, R12W N 00 E 10.60' (m. 10.59')

The selected location is accepted by me and is generally accepted by professional surveyors as the best available evidence
 of the position of the original corner.

C Description of monument for corner and accessories established to perpetuate locating the position of the corner:

A-9 Standard Kent County Monument on the Town Line

Nail & K.C. remon. tag on SE side Twin 16" Cherry S 60° W 33.49'

Nail & K.C. remon. tag on N side 18" Maple N 55° W 55.02'

Nail & K.C. remon. tag on W side 26" Maple N 05° W 70.01'

Nail & K.C. remon. tag on SE side P. pole N 40° E 45.63'

Nail & K.C. remon. tag on SW side 8" Maple S 55° E 42.97'

Nail & K.C. remon. tag on W side 12" Ash S 05° W 33.05'

SE cor. 24 T5N, R12W, (K.C. Monument) N 00° W 10.59'

Signed by Randy J. Kolehouse

Date 7/23/96

EARTH TECH

Surveyor's Michigan License No. 25854

