

SURVEY & REMONUMENTATION


FEB 14 1997

LAND CORNER RECORDATION CERTIFICATE
Filing Requirement of Act 74, Mich. P.A. 1970
KENT COUNTY REMONUMENTATION

For corners in **COMMISSION**

Kent (County)	Located in:	Gaines Township	Corner Code #
Public Land Survey	T <u>5N</u>	R <u>11W</u>	<u>A-10</u>
	T _____	R _____	_____
	T _____	R _____	_____
	T _____	R _____	_____
2 Property Controlling in Section	S _____	T _____	R _____
	S _____	T _____	R _____
3 Miscellaneous	S _____	T _____	R _____
Property in Sec.	S _____	T _____	R _____
4 Lot No. _____, Recorded Plat _____			
5 Private Claims _____			

STATE OF MICHIGAN
 COUNTY OF KENT
 RECEIVED FOR RECORD
 96 AUG -8 AM 8:38
 REG. OF DEEDS
Lucy Bond
9210
 Register of Deeds Stamp & File Number

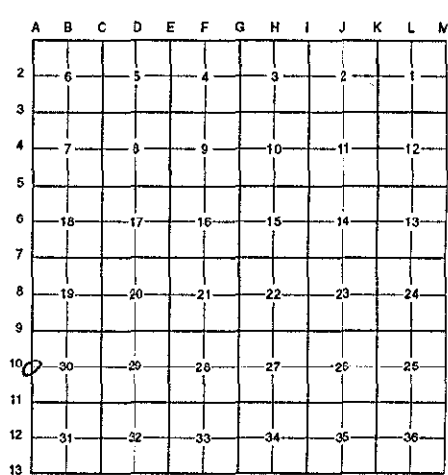

Randy Kolehouse, in a field survey on January 5 19 96, do hereby certify that under requirements of P.A. 74 Michigan P.A. of 1970, the corner points mentioned in lines 1 and 2 above were in conformance with regulations and rules therefore as required in the current manual of survey instructions of the United States Department of the interior, Bureau of Land Management or by a decree of a Court of Law and/or that the corner points mentioned in lines 3, 4 and 5 above were in conformance with the rules of the Michigan Board of Land Surveyors or by a Decree of a Court of Law; established, re-established, monumented, re-monumented, recovered, found as expressed below:

NOTE: Not more than 4 corners, all in the same town and range, may be recorded on this certificate.

A Description of original monument and accessories and/or subsequent restoration:

A-10 This corner was not originally set by the G.L.O.

1966	Witness Map	K.C. Surveyor	Iron on Fence Line
1977	L.C.R.C. #1077	Williams & Works	Found 1 1/2" Iron Pipe
1981	L.C.R.C. #2141	Jonker Land Survey	Found 1 1/2" Iron Pipe/Set K.C. Monument
1991	L.C.R.C. #6370	Chris Marschall	K.C. Monument

P.A. 345 1990 KENT COUNTY
 PEER APPROVED 7/17/96
 CHAIRMAN Randy Kolehouse

Note: This corner is common with M-10, T5N, R12W.

This corner was originally approved by the Kent County Remonumentation Peer Group and monumented by Jonker Land Surveys on 9/22/81 and was recorded per L.C.R.C. #2141.

B Description of corner evidence found and/or method applied in restoring or reestablishing corner:

A-10 Found standard Kent County Monument on intersection of fallen farm fences running West and North per L.C.R.C.'s #2141 and #6370 as set by Jonker Land Surveys in place of 1 1/2" iron pipe they found which checked L.C.R.C. #1077.

L.C.R.C. #2141

L.C.R.C. #6370


Remon. tag on S side 10" Elm S80°E 12.85'	Nail & Tag S sd 12" Elm S 80 E 12.87'
Remon. tag on E side 14" Ash N10°W 26.55'	Nail & Tag SE sd 18" Maple S 80 W 11.48'
Remon. tag on SE side 14" Maple S80°W 11.45'	Nail & Tag E sd 16" Ash N 10 W 26.54'
Remon. tag on W side 6" Ash S40°E 20.92'	Nail & Tag W sd 8" Ash S 40 E 20.92'

The selected location is accepted by me and is generally accepted by professional surveyors as the best available evidence of the position of the original corner.

C Description of monument for corner and accessories established to perpetuate locating the position of the corner:

A-10 Standard Kent County Monument

- Nail & K.C. remon. tag on S side 12" Elm S 80° E 12.87'
- Nail & K.C. remon. tag on SE side 18" Maple S 80° W 11.48'
- Nail & K.C. remon. tag on E side 16" Ash N 10° W 26.54'
- Nail & K.C. remon. tag on W side 8" Ash S 40° E 20.92'
- Fence post (wooden) N 45° W 0.5'

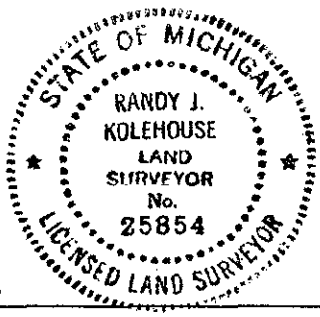

Signed by Randy J. Kolehouse Date 7/23/96
 EARTH TECH

Surveyor's Michigan License No. 25854