

FEB 14 1997

COMMISSION


**LAND CORNER RECORDATION CERTIFICATE  
Filing Requirement of Act 74, Mich. P.A. 1970  
KENT COUNTY REMONUMENTATION**

For corners in

Kent (County)	Located in:	Gaines Township	Corner Code #
1. Public Land Survey	T <u>5N</u>	R <u>11W</u>	<u>B-5</u>
	T _____	R _____	_____
	T _____	R _____	_____
	T _____	R _____	_____
2. Property Controlling in Section	S _____	T _____	R _____
	S _____	T _____	R _____
3. Miscellaneous Property in Sec.	S _____	T _____	R _____
	S _____	T _____	R _____

STATE OF MICHIGAN  
COUNTY OF KENT  
RECEIVED FOR RECORD  
96 AUG -8 AM 8:38  
REG. OF DEEDS  
*[Signature]*  
**9216**  
Register of Deeds Stamp & File Number

4. Lot No. \_\_\_\_\_, Recorded Plat \_\_\_\_\_  
5. Private Claims \_\_\_\_\_

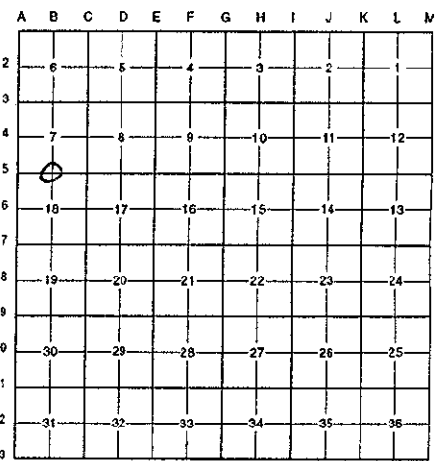

Randy Kolehouse, in a field survey on January 23 19 96, do hereby certify that under requirements of P.A. 74 Michigan P.A. of 1970, the corner points mentioned in lines 1 and 2 above were in conformance with regulations and rules therefore as required in the current manual of survey instructions of the United States Department of the Interior, Bureau of Land Management or by a decree of a Court of Law and/or that the corner points mentioned in lines 3, 4 and 5 above were in conformance with the rules of the Michigan Board of Land Surveyors or by a Decree of a Court of Law; established, re-established, monumented, re-monumented, recovered, found as expressed below:

**NOTE:** Not more than 4 corners, all in the same town and range, may be recorded on this certificate.

**A. Description of original monument and accessories and/or subsequent restoration:**

B-5	1831	G.L.O. Notes	Mullett	Set Post
	1940	Witness Map	K.C. Surveyor	Concrete Monument
	1971	L.C.R.C. #32	Williams & Works	1 3/4" Iron in Monument Box
	1980	L.C.R.C. #1740	Williams & Works	Fnd. 1 3/4" Iron over Conc. Mon. / Set K.C. Monument
	1989	L.C.R.C. #5010	J. Bueche	K.C. Monument in Monument Box
	1993	L.C.R.C. #6882	J. Bueche	Set K.C. Monument

P.A. 345 1990 KENT COUNTY  
PEER APPROVED 3/7/96  
CHAIRMAN *[Signature]*

This corner was originally approved by the Kent County Remonumentation Peer Group and monumented by Williams & Works on 12/16/80 and was recorded per L.C.R.C. #1740.

**B. Description of corner evidence found and/or method applied in restoring or reestablishing corner:**


B-5 Found a Standard Kent County Monument in the C/L of 76th Street (bit.) running East and West on a fence line running N as reset by J. Bueche after road construction removed K.C. Monument, concrete monument and monument box as shown in L.C.R.C.'s #32, #1740 and #5010. Monument checks L.C.R.C. #6882 and also checks location of corner from L.C.R.C.'s #32, #1740 and LMN survey notes from 1992.

L.C.R.C. #5010	L.C.R.C. #6882
Nail & Remon Tag W side p. pole N 32° E 61.70' On fence C/L tree row North & South	Conc. Nail & Tag in W side 14" Elm N 03° W 46.47' PK Nail NW side PP N 28° E 61.68' NW cor. back of CB grate N 42° W 34.93' SW cor. back of CB grate S 45° W 34.05' C/L E-W bit. road Tree lines N-S

The selected location is accepted by me and is generally accepted by professional surveyors as the best available evidence of the position of the original corner.

**C. Description of monument for corner and accessories established to perpetuate locating the position of the corner:**

B-5 Standard Kent County Monument  
Nail & K.C. remon. tag on N side 14" Elm N 03° W 46.47'  
Nail & K.C. remon. tag on NW side P. pole N 28° E 61.71'  
Nail & K.C. remon. tag on W side P. pole S 00° E 30.05'  
C/L top fence post (chain link) S 11° E 50.34'  
SW corner curb at back of curb S 45° W 34.01'  
NW corner curb at back of curb N 42° W 34.97'

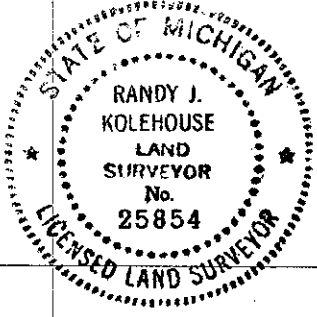

Signed by *Randy J. Kolehouse* Date 7/23/96  
EARTH TECH

Surveyor's Michigan License No. 25854