

KENT COUNTY REMONUMENTATION
 LAND CORNER RECORDATION CERTIFICATE

Filing Requirement of Act 74, Mich. P.A. 1970

KENT COUNTY
 REGISTERED

AUG 26 1993

For corners in

Kent
 (County)

Located In: Gaines Township
 Corner Code #/

- | | | | | | |
|------------------------------------|---|-----------|---|------------|----------------------------------|
| 1. Public Land Survey | T | <u>5N</u> | R | <u>11W</u> | <u>B-6 Center of Section 18.</u> |
| | T | | R | | |
| | T | | R | | |
| | T | | R | | |
| 2. Property Controlling in Section | S | | T | | |
| | S | | T | | |
| 3. Miscellaneous Property in Sec. | S | | T | | |
| | S | | T | | |
4. Lot No. _____, Recorded Plat _____
5. Private Claims _____

Seg-1

6832 A

Register of Deeds Stamp & File Number

Chris Marschall, in a field survey on June 7, 1993

do hereby certify that under requirements of P.A. 74, Michigan P.A. of 1970, the corner points mentioned in lines 1 and 2 above were in conformance with regulations and rules therefore as required in the current manual of survey instructions of the United States Department of the Interior, Bureau of Land Management or by a decree of a Court of Law and/or that the corner points mentioned in lines 3, 4 and 5 above were in conformance with the rules of the Michigan Board of Land Surveyors or by a Decree of a Court of Law; established, re-established, monumented, re-monumented, recovered, found as expressed below:

NOTE: Not more than 4 corners, all in the same town and range, may be recorded on this certificate.


A. Description of original monument and accessories and/or subsequent restoration:

- Iron 1973 M & V
- 6" Basswood SE 5.00'
- 24" Oak S 61.30'
- 12" - 24" CLP Basswood SW 18.82'
- Fence ROW to SO' E or W.
- Fence ROW to W2' S
- Fence ROW to E4' S

B. Description of corner evidence found and/or method applied in restoring or reestablishing corner:

Found 3/4" x 18" Iron pipe from above witnesses
 Pipe was 0.29' West and 2.34' South of Intersection of 1/4 lines.

A	B	C	D	E	F	G	H	I	J	K	L	M
2	6	5	4	3	2	1						
3												
4	7	8	9	10	11	12						
5												
6		17	16	15	14	13						
7												
8	19	20	21	22	23	24						
9												
10	30	29	28	27	26	25						
11												
12	31	32	33	34	35	36						
13												

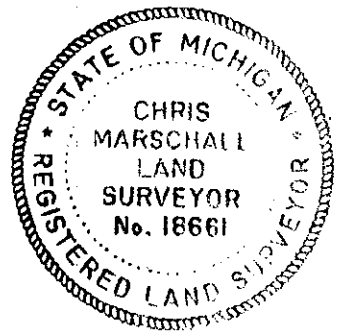

C. Description of monument for corner and accessories established to perpetuate locating the position of the corner:

- Replaced 3/4" x 18" Pipe with standard 36" K.C. Harrison Monument
- Fence corner post with fence running S & W South 2' more or less
- Fence corner post with fence running S & E South 3.7' more or less
- Fence corner post with fence running S & E South 16.1' more or less
- Nail & Tag NE sd 12" Mulberry S50° E 5.15'
- Nail & Tag W sd 42" Oak S03° W 61.62'
- Nail & Tag S sd 6" Ash S75° W 7.90'
- Nail & Tag N sd 6" Cherry N80° W 18.94'
- Nail & Tag SW sd 16" Maple N50° W 26.62'
- Centerline of a small creek North 8' more or less
- Nail & Tag S sd 4" Ash N60° E 20.73'

Signed by Chris Marschall

Date July 7, 1993

Surveyor's Michigan License No. 18661

See Other Side

Section 18 Town 5 N Range 11 W 6832B
 Township Gaines County

