

SURVEY & REMONUMENTATION

FFB 1 4 1997

COMMISSION

LAND CORNER RECORDATION CERTIFICATE
Filing Requirement of Act 74, Mich. P.A. 1970
KENT COUNTY REMONUMENTATION

For corners in

Kent (County)	Located in: Gaines Township	Corner Code #
1. Public Land Survey	T <u>5N</u> R <u>11W</u>	<u>B-7</u>
	T _____ R _____	_____
	T _____ R _____	_____
	T _____ R _____	_____
2. Property Controlling in Section	S _____ T _____ R _____	_____
	S _____ T _____ R _____	_____
3. Miscellaneous Property in Sec.	S _____ T _____ R _____	_____
	S _____ T _____ R _____	_____

REG. OF DEEDS

W. J. Cole

96 AUG -8 AM 8:38

STATE OF MICHIGAN
 COUNTY OF KENT
 RECEIVED FOR RECORD

9217

Register of Deeds Stamp & File Number

4. Lot No. _____, Recorded Plat _____
 5. Private Claims _____

I, Randy Kolehouse, in a field survey on January 23 19 96, do hereby certify that under requirements of P.A. 74 Michigan P.A. of 1970, the corner points mentioned in lines 1 and 2 above were in conformance with regulations and rules therefore as required in the current manual of survey instructions of the United States Department of the Interior, Bureau of Land Management or by a decree of a Court of Law and/or that the corner points mentioned in lines 3, 4 and 5 above were in conformance with the rules of the Michigan Board of Land Surveyors or by a Decree of a Court of Law; established, re-established, monumented, re-monumented, recovered, found as expressed below:

NOTE: Not more than 4 corners, all in the same town and range, may be recorded on this certificate.


A. Description of original monument and accessories and/or subsequent restoration:

B-7	1831	G.L.O. Notes	Mullett	Set Post
	1963	Witness Map	K.C. Surveyor	Iron
	1973	L.C.R.C. #553	Medema, Van Kooten & Assoc.	Iron in Monument Box
	1982	L.C.R.C. #2928	Exxel Engineering	Fnd. Iron in Mon. Box / Set K.C. Monument
	1989	L.C.R.C. #5011	J. Bueche	K.C. Monument

P.A. 345 1990 KENT COUNTY

PEER APPROVED 3/7/96

CHAIRMAN *W. J. Cole*

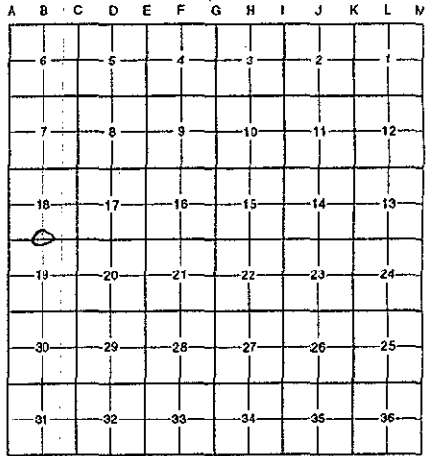

This corner was originally approved by the Kent County Remonumentation Peer Group and monumented by Exxel Engineering on May 3, 1982 and was recorded per L.C.R.C. #2928.

B. Description of corner evidence found and/or method applied in restoring or reestablishing corner:

B-7 Found a Standard Kent County Monument in a monument box in the C/L of 84th Street (bit.) per L.C.R.C.'s #2928 and #5011 as set by Exxel Engineering in place of a 1" iron they found which checked L.C.R.C. #553 and the K.C. Surveyor's records.

L.C.R.C. #2928

L.C.R.C. #5011

Nail & KC tag in W sde Twin 24" Walnut N 15° E 41.34'
 Nail & KC tag in N sde 12" Walnut S 80° W 135.53'
 SE edge steel "I" beam N 38° E 79.20'
 PK in top of 24" concrete culvert pipe S 50° E 38.46'


Nail & RemonTag in W side twin 28" Walnut N 15° E 41.34'
 Nail & Remon Tag in N side 16" Walnut 80° W 135.53'
 SE edge steel "I" beam N 38° E 79.20'
 PK in top of 24" concrete culvert pipe S 50° E 38.46'
 Nail & Remon Tag in w side 13" Maple S.20° W 90.08'

The selected location is accepted by me and is generally accepted by professional surveyors as the best available evidence of the position of the original corner.

C. Description of monument for corner and accessories established to perpetuate locating the position of the corner:

B-7 Standard Kent County Monument in a Monument Box

Nail & K.C. remon. tag on W side 14" Maple S 20° W 90.11'
 Nail & K.C. remon. tag on W side 30" Pine S 32° E 101.06'
 PK & tag on top 24" conc. culv. S 50° E 38.41'
 SE edge steel "I" beam N 38° E 79.18'
 Nail & K.C. remon. tag on W side Twin 24" Walnut N 01° SE 41.25'

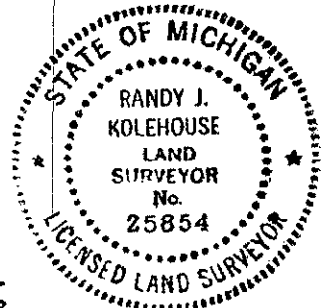

Signed by Randy J. Kolehouse

Date 7/23/96

Surveyor's Michigan License No. 25854