

\$7.00
\$2.00

JAN 23 1996

COMMISSION

LAND CORNER RECORDATION CERTIFICATE
Filing Requirement of Act 74, Mich. P.A. 1970
KENT COUNTY REMONUMENTATION

For corners in

Kent
(County)

Located in:

Corner Code #

1. Public Land Survey	T <u>5N</u>	R <u>11W</u>	<u>B-8</u>
	T _____	R _____	_____
	T _____	R _____	_____
	T _____	R _____	_____
2. Property Controlling in Section	S _____	T _____	R _____
	S _____	T _____	R _____
3. Miscellaneous Property in Sec.	S _____	T _____	R _____
	S _____	T _____	R _____

- 4. Lot No. _____, Recorded Plat _____
- 5. Private Claims _____

STATE OF MICHIGAN
COUNTY OF KENT
RECEIVED FOR RECORD

95 DEC 28 PM 2:21

REG. OF DEEDS

Lucy Bond

8902

Register of Deeds Stamp & File Number

I, Randy Kolehouse, in a field survey on May 16 19 95, do hereby certify that under requirements of P.A. 74 Michigan P.A. of 1970, the corner points mentioned in lines 1 and 2 above were in conformance with regulations and rules therefore as required in the current manual of survey instructions of the United States Department of the interior, Bureau of Land Management or by a decree of a Court of Law and/or that the corner points mentioned in lines 3, 4 and 5 above were in conformance with the rules of the Michigan Board of Land Surveyors or by a Decree of a Court of Law; established, re-established, monumented, re-monumented, recovered, found as expressed below:

NOTE: Not more than 4 corners, all in the same town and range, may be recorded on this certificate.

A. Description of original monument and accessories and/or subsequent restoration:

B-8 This corner was not originally set by the G.L.O.

1941	Survey Notes	Williams & Works	Set Iron at Int. of 1/4 Lines
1941	Wit. Map	K.C. Surveyor	Iron
1974	L.C.R.C. #739	Exxel Engineering	Fnd. 1/2" Iron Checks Previous Wit.

B. Description of corner evidence found and/or method applied in restoring or reestablishing corner:

B-8 Found a 1/2" iron per L.C.R.C. #739 as used by Exxel Engineering using K.C. Witness Map. Iron is 5' West of a fence running North & South and 10' south of fence running East and West. This iron is 0.5' East and 1.8' North of true position. This is verified by measurements from Exxel Engineering. This iron has been used by Williams & Works and Exxel Engineering since 1941 and has been historically accepted as the Center of Section. Accepted 1/2" iron as Center Section.

L.C.R.C. #739


- Nail in sde 30" Maple NW 12.75'
- Nail in sde 30" Maple NE 20.84'
- Nail in sde 38" Maple East 42.0'

P.A. 345 1990 KENT COUNTY
PEER APPROVED 8/26/89
CHAIRMAN *Harry Kahman*

C. Description of monument for corner and accessories established to perpetuate locating the position of the corner:

B-8 Replaced 1/2" iron with a Standard 4" x 30" Kent County Monument.

- Nail & cap in NW face 30" Maple N 50° E 20.84'
- Nail & cap in S face 38" Maple East 42.00'
- Nail & K.C. remon. tag in S face 32" Maple N 50° W 12.77'
- Nail & K.C. remon. tag in E face 10" Ash S 30° E 22.41'

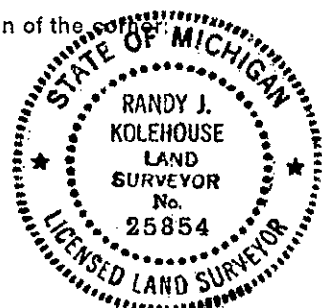

Signed by *Randy J. Kahman* Date 12/22/95
EARTH TECH

Surveyor's Michigan License No. 25854

