

SURVEY & REMONUMENTATION

FEB 14 1997

COMMISSION

LAND CORNER RECORDATION CERTIFICATE
Filing Requirement of Act 74, Mich. P.A. 1970
KENT COUNTY REMONUMENTATION

For corners in

Kent (County)	Located in: Gains Township	Corner Code #
1. Public Land Survey	T <u>5N</u> R <u>11W</u>	<u>B-9</u>
	T _____ R _____	_____
	T _____ R _____	_____
	T _____ R _____	_____
2. Property Controlling in Section	S _____ T _____ R _____	_____
	S _____ T _____ R _____	_____
3. Miscellaneous Property in Sec.	S _____ T _____ R _____	_____
	S _____ T _____ R _____	_____

REG. OF DEEDS

Lucy Bond

96 AUG -8 AM 8:38

STATE OF MICHIGAN
 COUNTY OF KENT
 RECEIVED FOR RECORD


9218

Register of Deeds Stamp & File Number

4. Lot No. _____, Recorded Plat _____
 5. Private Claims _____

Randy Kolehouse, in a field survey on January 22 19 96, do hereby certify that under requirements of P.A. 74 Michigan P.A. of 1970, the corner points mentioned in lines 1 and 2 above were in conformance with regulations and rules therefore as required in the current manual of survey instructions of the United States Department of the Interior, Bureau of Land Management or by a decree of a Court of Law and/or that the corner points mentioned in lines 3, 4 and 5 above were in conformance with the rules of the Michigan Board of Land Surveyors or by a Decree of a Court of Law; established, re-established, monumented, re-monumented, recovered, found as expressed below:

NOTE: Not more than 4 corners, all in the same town and range, may be recorded on this certificate.

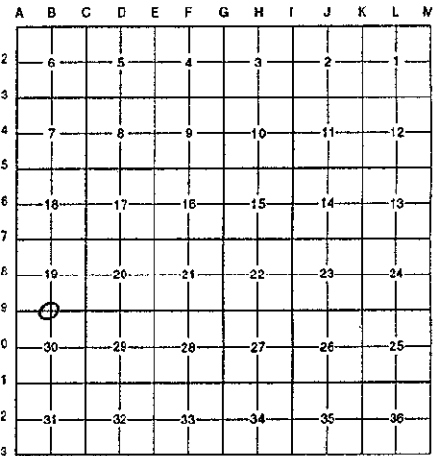

A. Description of original monument and accessories and/or subsequent restoration:

B-9	1831	G.L.O. Notes	Mullett	Set Post
	1959	Witness Map	K.C. Surveyor	Iron
	1972	L.C.R.C. #359	Exxel Engineering	1/2" Iron Pipe
	1982	L.C.R.C. #2918	Exxel Engineering	Fnd. 1/2" Iron Over a 1" Iron / Set K.C. Monument
	1989	L.C.R.C. #5012	J. Bueche	K.C. Monument

P.A. 345 1990 KENT COUNTY

PEER APPROVED 3/2/96

CHAIRMAN *Henry Huber*

This corner was originally approved by the Kent County Remonumentation Peer Group and monumented by Exxel Engineering on 6/2/82 and was recorded per L.C.R.C. #2918.

B. Description of corner evidence found and/or method applied in restoring or reestablishing corner:

B-9 Found a Standard Kent County Monument 2.5' North of the C/L of 92nd Street (bit.) running East and West per L.C.R.C.'s #359, #2918 and #5012 as set by Exxel Engineering in place of a 1/2" iron over a 1" iron they found which checked L.C.R.C. #359 and the K.C. Surveyor's records.

L.C.R.C. #2918

L.C.R.C. #5012

SW corner house N 52° W 126.04'
 SE corner house N 12° W 73.42'
 Nail & KC tag in N sde 12" Maple S 62° W 57.36'
 Nail & KC tag in E sde Locust South 63.63'

SW corner house N 52° W 126.04'
 SE corner house N 12° W 73.42'
 Nail & Remon Tag in N side 16" Maple S 62° W 57.36'
 Nail & Remon Tag in E side 12" Locust South 63.63'

The selected location is accepted by me and is generally accepted by professional surveyors as the best available evidence of the position of the original corner.

C. Description of monument for corner and accessories established to perpetuate locating the position of the corner:

B-9 Standard Kent County Monument in a Monument Box

Nail & K.C. remon. tag on NW side 18" Maple S 62° W 57.05'
 Nail & K.C. remon. tag on E side P. pole S 25° W 44.04'
 Nail & K.C. remon. tag on E side 24" Locust South 63.57'
 USGS mon. North 22.50'
 Nail & K.C. remon. tag on W side 24" Walnut N 05° W 31.31'
 SE corner house (wood) N 12° W 73.42'
 SW corner house (brick) N 52° W 126.04'



Signed by Randy J. Kolehouse

Date 7/23/96

Surveyor's Michigan License No. 25854