

\$7.00  
\$2.00

JAN 23 1996

COMMISSION

LAND CORNER RECORDATION CERTIFICATE  
Filing Requirement of Act 74, Mich. P.A. 1970  
KENT COUNTY REMONUMENTATION

For corners in

Kent (County)	Located in:	Corner Code #
1. Public Land Survey	T <u>5N</u> R <u>11W</u>	<u>B-10</u>
	T _____ R _____	_____
	T _____ R _____	_____
	T _____ R _____	_____
2. Property Controlling in Section	S _____ T _____ R _____	_____
	S _____ T _____ R _____	_____
3. Miscellaneous Property in Sec.	S _____ T _____ R _____	_____
	S _____ T _____ R _____	_____
4. Lot No. _____, Recorded Plat _____		
5. Private Claims _____		

STATE OF MICHIGAN  
COUNTY OF KENT  
RECEIVED FOR RECORD


95 DEC 28 PM 2:21

REG. OF DEEDS  
*Luis J. Bond*

8903

Register of Deeds Stamp & File Number

I, Randy Kolehouse, in a field survey on May 18 19 95, do hereby certify that under requirements of P.A. 74 Michigan P.A. of 1970, the corner points mentioned in lines 1 and 2 above were in conformance with regulations and rules therefore as required in the current manual of survey instructions of the United States Department of the interior, Bureau of Land Management or by a decree of a Court of Law and/or that the corner points mentioned in lines 3, 4 and 5 above were in conformance with the rules of the Michigan Board of Land Surveyors or by a Decree of a Court of Law; established, re-established, monumented, re-monumented, recovered, found as expressed below:

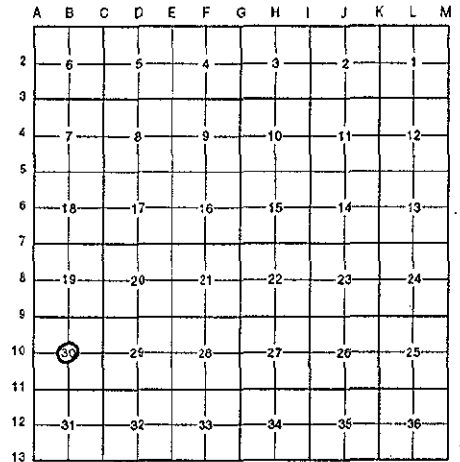

NOTE: Not more than 4 corners, all in the same town and range, may be recorded on this certificate.

A. Description of original monument and accessories and/or subsequent restoration:

B-10 This corner was not originally set by the G.L.O.  
1989 Survey Exxel Engineering Found "T" Iron at Int. of 1/4 Lines

P.A. 345 1990 KENT COUNTY  
PEER APPROVED 10/26/95  
CHAIRMAN *Larry Huber*


B. Description of corner evidence found and/or method applied in restoring or reestablishing corner:

B-10 Found "T" iron per Exxel Engineering Survey (1989) to be within 0.2' of intersection of 1/4 lines. Accepted iron as Center Section.

C. Description of monument for corner and accessories established to perpetuate locating the position of the corner:

B-10 Replaced "T" iron with Standard 4" x 30" Kent County Monument.

Corner is in an open field with no witness objects in vicinity.  
W 1/4 Cor. Sec. 30, 5-11 West 2507.63'  
E 1/4 Cor. Sec. 30, 5-11 East 2653.63'  
S 1/4 Cor. Sec. 30, 5-11 South 2631.51'  
N 1/4 Cor. Sec. 30, 5-11 North 2634.15'

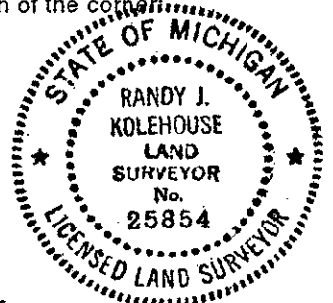

Signed by *Randy J. Kolehouse* Date 12/22/95  
EARTH TECH

Surveyor's Michigan License No. 25854