

SURVEY & REMONUMENTATION

FEB 14 1997

LAND CORNER RECORDATION CERTIFICATE
Filing Requirement of Act 74, Mich. P.A. 1970
KENT COUNTY REMONUMENTATION

For corners in

COMMISSION


STATE OF MICHIGAN
 COUNTY OF KENT
 RECEIVED FOR RECORD
 96 AUG -8 AM 8:39
 REG. OF DEEDS
L. J. Sand

Kent (County)	Located in: Gaines Township	Corner Code #
1 Public Land Survey	T <u>5N</u> R <u>11W</u>	<u>C-3</u>
	T _____ R _____	_____
	T _____ R _____	_____
	T _____ R _____	_____
2 Property Controlling in Section	S _____ T _____ R _____	_____
	S _____ T _____ R _____	_____
3 Miscellaneous Property in Sec.	S _____ T _____ R _____	_____
	S _____ T _____ R _____	_____

9223

Register of Deeds Stamp & File Number

4 Lot No. _____, Recorded Plat _____
 5 Private Claims _____

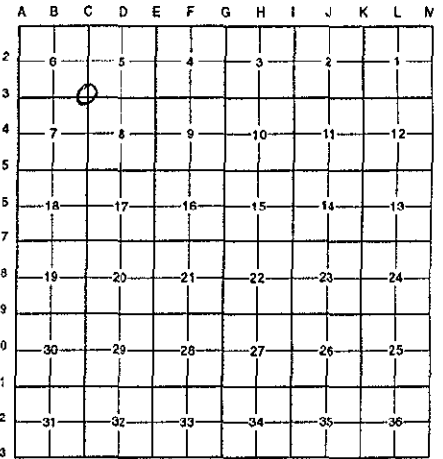

Randy Kolehouse, in a field survey on January 22 19 96, do hereby certify that under requirements of P.A. 74 Michigan P.A. of 1970, the corner points mentioned in lines 1 and 2 above were in conformance with regulations and rules therefore as required in the current manual of survey instructions of the United States Department of the Interior, Bureau of Land Management or by a decree of a Court of Law and/or that the corner points mentioned in lines 3, 4 and 5 above were in conformance with the rules of the Michigan Board of Land Surveyors or by a Decree of a Court of Law; established, re-established, monumented, re-monumented, recovered, found as expressed below:

NOTE: Not more than 4 corners, all in the same town and range, may be recorded on this certificate.

A Description of original monument and accessories and/or subsequent restoration:

C-3	1831	G.L.O. Notes	Mullett	Set Post	P.A. 345 1990 KENT COUNTY
	1966	Witness Map	K.C. Surveyor	Iron	PEER APPROVED <u>3/7/96</u>
	1972	L.C.R.C. #208	Exxel Engineering	Iron in Mon. Box	<i>Chairman [Signature]</i>
	1973	L.C.R.C. #389	Williams & Works	Iron in Mon. Box	
	1982	L.C.R.C. #2927	Exxel Engineering	Fnd. Iron in Mon. box / Set K.C. Monument	
	1989	L.C.R.C. #5016	J. Bueche	K.C. Monument	

This corner was originally approved by the Kent County Remonumentation Peer Group and monumented by Exxel Engineering on 6/3/82 and was recorded per L.C.R.C. #2927.

B Description of corner evidence found and/or method applied in restoring or reestablishing corner:

C-3 Found a Standard Kent County Monument in the C/L intersection of 68th Street (bit.) running E-W and Eastern Avenue (bit.) running N-S per L.C.R.C.'s #2927 and #5016 as set by Exxel Engineering in place of an iron in a monument box which they found that checked L.C.R.C.'s #208, #289 and the K.C. Surveyor's records.

L.C.R.C. #2927

NW cor. of church (by planter) S 30° E 118.11'
 NE corner house fndn. S 55° W 119.40'
 C/L SE bolt at base of light pole N 65° W 113.82'
 C/L SE bolt at base of light pole N 25° W 103.13'
 C/L manhole N 80° W 14.61'
 C/L blacktop N-S, E-W


L.C.R.C. #5016

NW corner of church (by planter) S 30° E 118.11' (m. 118.99)
 NE corner house fndn. S 55° W 119.40' (m. 119.32)
 C/L SE bolt at base of light pole N 65° W 113.82' (m. 113.78')
 C/L SE bolt at base of light pole N 25° W 103.13'
 C/L manhole N 80° W 14.61'

The selected location is accepted by me and is generally accepted by professional surveyors as the best available evidence of the position of the original corner.

C Description of monument for corner and accessories established to perpetuate locating the position of the corner:

C-3 Standard Kent County Monument
 C/L manhole N 80° W 14.61'
 C/L SE bolt at base of light pole N 65° W 113.78'
 NE cor. hse. fndn. S 55° W 119.32'
 NW cor. church S 30° E 118.99'
 Nail & K.C. remon. tag on NE side Guy pole N 25° W 74.74'
 Nail & K.C. remon. tag on NW side 22" Poplar N 50° E 123.14'

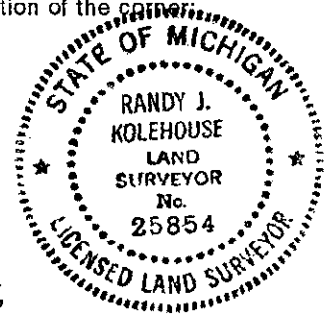

Signed by Randy J. Kolehouse
 EARTH TECH

Date 7/23/96

Surveyor's Michigan License No. 25854