

FEB 14 1997

COMMISSION

LAND CORNER RECORDATION CERTIFICATE
Filing Requirement of Act 74, Mich. P.A. 1970
KENT COUNTY REMONUMENTATION

For corners in


Table with columns: Kent (County), Located in: Gains Township, Corner Code #. Rows include Public Land Survey, Property Controlling in Section, Miscellaneous Property in Sec.

STATE OF MICHIGAN
COUNTY OF KENT
RECEIVED FOR RECORD
96 AUG -8 AM 8:39
REG. OF DEEDS
[Signature]

9224

Register of Deeds Stamp & File Number

Lot No. \_\_\_\_\_, Recorded Plat \_\_\_\_\_
Private Claims \_\_\_\_\_

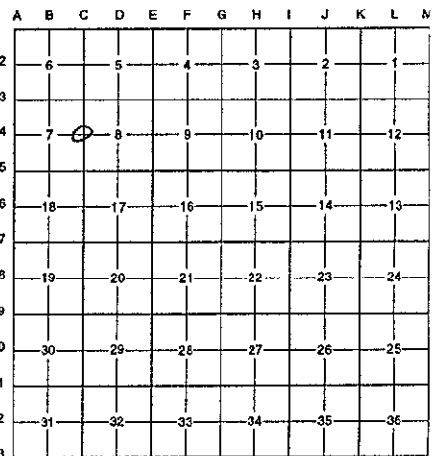

I, Randy Kolehouse, in a field survey on January 22 19 96, do hereby certify that under requirements of P.A. 74 Michigan P.A. of 1970, the corner points mentioned in lines 1 and 2 above were in conformance with regulations and rules therefore as required in the current manual of survey instructions of the United States Department of the interior, Bureau of Land Management or by a decree of a Court of Law and/or that the corner points mentioned in lines 3, 4 and 5 above were in conformance with the rules of the Michigan Board of Land Surveyors or by a Decree of a Court of Law; established, re-established, monumented, re-monumented, recovered, found as expressed below:

NOTE: Not more than 4 corners, all in the same town and range, may be recorded on this certificate.

A Description of original monument and accessories and/or subsequent restoration:

Table with 4 columns: Corner Code, Date, Description, Monument Type. Includes entries for G.L.O. Notes, Witness Map, L.C.R.C. #756, #2924, #5017, Mullett, K.C. Surveyor, Williams & Works, Exxel Engineering, J. Bueche, Set Post, Monument, 1" Iron in Mon. Box, Fnd. 3/4" Iron in Mon. Box / Set K.C. Monument, K.C. Monument.

P.A. 345 1990 KENT COUNTY

PEER APPROVED 3/7/96

CHAIRMAN [Signature]

This corner was originally approved by the Kent County Remonumentation Peer Group and monumented by Exxel Engineering on 6/3/82 and was recorded per L.C.R.C. #2924.

B Description of corner evidence found and/or method applied in restoring or reestablishing corner:

C-4 Found a Standard Kent County Monument in the C/L of Eastern Avenue (bit.) running N-S and 2' South of the C/L of 72nd Street (bit.) running West per L.C.R.C.'s #756, 2924 and #5017 as set by Exxel Engineering in place of a 3/4" iron in a monument box which they found that checked L.C.R.C. #56 and the K.C. Surveyor's records.

L.C.R.C. #756

L.C.R.C. #2924

L.C.R.C. #5017

CP pole S 45° W 54.1' Nail & KC tag in W'ly side 36" Ash N 30° E 68.86' Nail & Remon tag in W'ly side 40" Ash N 30° E 68.86' (m. 68.81')
20" Ash N 45° E 67.36' NE corner House (brick corner) S 44° W 128.05' NE cor. house (brick house) S 44° W 128.05' (m. 128.00')
CP pole S 50° E 51.55' SE corner concrete walks N 49° W 101.44' SE cor. concrete walks N 49° W 101.44'
Nail & KC tag in S sde 18" Oak N 78° W 162.59' Nail & Remon Tag in S side 20" Oak N 78° W 162.59' (m. 162.62')
NW cor. hse #7204 (brick) S 80° E 97.60'
NW cor. hse #7218 (brick) S 45° E 131.25'
C/L blacktop N-S
C/L blacktop West, North 2' ±

The selected location is accepted by me and is generally accepted by professional surveyors as the best available evidence of the position of the original corner.

C Description of monument for corner and accessories established to perpetuate locating the position of the corner:

C-4 Standard Kent County Monument

Nail & K.C. remon. tag on W side 40" Ash N 30° E 68.81'
NW cor. hse. #7204 (brick) S 80° E 97.60'
NE cor. hse. brick S 44° W 128.00'
Nail & K.C. remon. tag on S side 20" Oak N 78° W 162.62'
SE cor. conc. walks N 49° W 101.44'

Signed by Randy J. Kolehouse

Date 7/23/96

EARTH TECH

Surveyor's Michigan License No. 25854

