

**SURVEY &
REMONUMENTATION**

FEB 14 1997

COMMISSION

LAND CORNER RECORDATION CERTIFICATE

Filing Requirement of Act 74, Mich. P.A. 1970

KENT COUNTY REMONUMENTATION

For corners in

Kent (County)	Located in: Gaines Township	Corner Code #
1 Public Land Survey	T <u>5N</u> R <u>11W</u>	<u>C-7</u>
	T _____ R _____	_____
	T _____ R _____	_____
	T _____ R _____	_____
2 Property Controlling in Section	S _____ T _____ R _____	_____
	S _____ T _____ R _____	_____
3 Miscellaneous Property in Sec.	S _____ T _____ R _____	_____
	S _____ T _____ R _____	_____

STATE OF MICHIGAN
COUNTY OF KENT
RECEIVED FOR RECORD

96 AUG - 8 AM 8:39

REG. OF DEEDS

Luigi St. Paul

9227

Register of Deeds Stamp & File Number

4 Lot No. _____, Recorded Plat _____
5 Private Claims _____

I, Randy Kolehouse, in a field survey on January 22 19 96, do hereby certify that under requirements of P.A. 74 Michigan P.A. of 1970, the corner points mentioned in lines 1 and 2 above were in conformance with regulations and rules therefore as required in the current manual of survey instructions of the United States Department of the Interior, Bureau of Land Management or by a decree of a Court of Law and/or that the corner points mentioned in lines 3, 4 and 5 above were in conformance with the rules of the Michigan Board of Land Surveyors or by a Decree of a Court of Law; established, re-established, monumented, re-monumented, recovered, found as expressed below:

NOTE: Not more than 4 corners, all in the same town and range, may be recorded on this certificate.


A Description of original monument and accessories and/or subsequent restoration:

C-7	1831	G.L.O. Notes	Mullett	Set Post
	1963	Witness Map	K.C. Surveyor	1/2" Iron
	1980	L.C.R.C. #1389	Exxel Engineering	Iron in Monument Box
	1982	L.C.R.C. #2913	Exxel Engineering	Iron in Mon. Box / Set K.C. Monument
	1989	L.C.R.C. #5020	J. Bueche	K.C. Monument

P.A. 345 1990 KENT COUNTY
PEER APPROVED 3/27/96
CHAIRMAN *Harry Huber*

This corner was originally approved by the Kent County Remonumentation Peer Group and monumented by Exxel Engineering on 6/2/82 and was recorded per L.C.R.C. #2913.

B Description of corner evidence found and/or method applied in restoring or reestablishing corner:

C-7 Found a Standard Kent County Monument at the C/L intersection of 84th Street (bit.) running E-W and Eastern Avenue (bit.) running N-S per L.C.R.C.'s #2913 and #5020 as set by Exxel Engineering in place of an iron in a monument box which they found that checked L.C.R.C. #1389 and K.C. Surveyor's records.

L.C.R.C. #2913

L.C.R.C. #5020

Nail & tag in W sde 30" Maple S 10° E 115.71'
Nail & tag in S sde dbl 12" apple S 51° E 85.78'
PK in tag in top of concrete culvert N 42° W 49.68'
PK in tag at E end of concrete curb and gutter plan N 72° E 41.93'
Corner is at C/L "X" of blacktop roads


Nail & Remon Tag in W side 34" Maple S 10° E 115.71'
Nail & Remon Tag in S side dbl 14" Apple S 51° E 85.78'
PK in Remon Tag in top of concrete culvert N 42° W 49.68' (m. 49.72)
PK in Remon Tag at E end of concrete curb and gutter pan N 72° E 41.93'
Corner is at C/L "X" of blacktop roads

The selected location is accepted by me and is generally accepted by professional surveyors as the best available evidence of the position of the original corner.

C Description of monument for corner and accessories established to perpetuate locating the position of the corner:

C-7 Standard Kent County Monument

Nail & K.C. remon. tag on NW side GTE pole S 40° W 40.70'
PK & tag top concrete culvert N 42° W 49.72'
Nail & K.C. remon. tag on SE side L. pole N 40° E 39.02'
Nail & K.C. remon. tag on W side 34" Maple S 10° E 115.71'
Nail & K.C. remon. tag on S side Double Apple S 51° E 85.78'

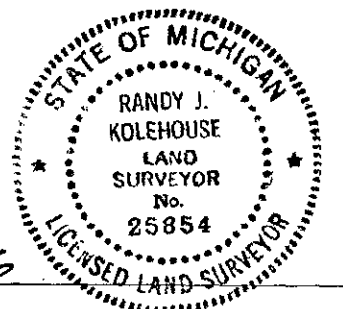

Signed by *Randy J. Kolehouse* Date 7/23/96

Surveyor's Michigan License No. 25854