

SURVEY & REMONUMENTATION COMMISSION

FEB 14 1997

LAND CORNER RECORDATION CERTIFICATE
Filing Requirement of Act 74, Mich. P.A. 1970
KENT COUNTY REMONUMENTATION

For corners in

Kent (County)	Located in:	Gaines Township	Corner Code #
1. Public Land Survey	T <u>5N</u>	R <u>11W</u>	<u>C-9</u>
	T _____	R _____	_____
	T _____	R _____	_____
	T _____	R _____	_____
2. Property Controlling in Section	S _____	T _____	R _____
	S _____	T _____	R _____
3. Miscellaneous Property in Sec.	S _____	T _____	R _____
	S _____	T _____	R _____

REG. OF DEEDS

Handwritten signature

STATE OF MICHIGAN
 COUNTY OF KENT
 RECEIVED FOR RECORD
 96 AUG -8 AM 8:39

9229

Register of Deeds Stamp & File Number

4. Lot No. _____, Recorded Plat _____
 5. Private Claims _____


I, Randy Kolehouse, in a field survey on January 23 19 96, do hereby certify that under requirements of P.A. 74 Michigan P.A. of 1970, the corner points mentioned in lines 1 and 2 above were in conformance with regulations and rules therefore as required in the current manual of survey instructions of the United States Department of the interior, Bureau of Land Management or by a decree of a Court of Law and/or that the corner points mentioned in lines 3, 4 and 5 above were in conformance with the rules of the Michigan Board of Land Surveyors or by a Decree of a Court of Law; established, re-established, monumented, re-monumented, recovered, found as expressed below:

NOTE: Not more than 4 corners, all in the same town and range, may be recorded on this certificate.

A. Description of original monument and accessories and/or subsequent restoration:

C-9	1831	G.L.O. Notes	Mullett	Set Post
	1960	Witness Map	K.C. Surveyor	Iron
	1972	L.C.R.C. #236	Williams & Works	"T" Iron in Mon. Box
	1982	L.C.R.C. #2922	Exxel Engineering	Fnd. "T" Iron in Mon. Box / Set K.C. Monument
	1989	L.C.R.C. #5022	J. Bueche	K.C. Monument in Mon. Box

P.A. 345 1990 KENT COUNTY
 PEER APPROVED 3/27/96
 CHAIRMAN *Handwritten signature*

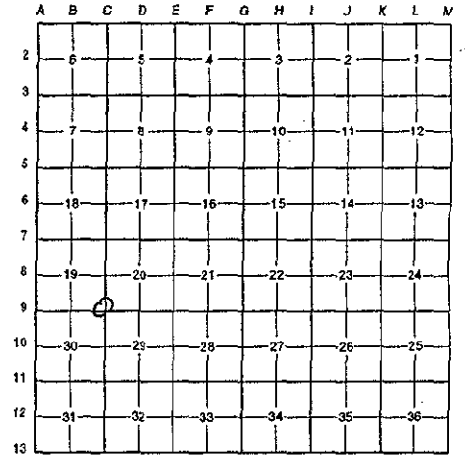

This corner was originally approved by the Kent County Remonumentation Peer Group and monumented by Exxel Engineering on 6/4/82 and was recorded per L.C.R.C. #2922.

B. Description of corner evidence found and/or method applied in restoring or reestablishing corner:

C-9 Found a Standard Kent County Monument in a monument box 6' West of the C/L intersection of Eastern Avenue (bit.) running N & S and 92nd Street (bit.) running E & W per L.C.R.C.'s #2922 and #5022 as set by Exxel Engineering in place of a "T" iron in a monument box they found which checked L.C.R.C. #236.

L.C.R.C. #2922

Nail & KC tag in NE sde clump 6" Ash N 27° W 54.28'
 Nail & KC tag in N sde 12" Pear S 63° E 112.55'
 Nail & KC tag in S sde 10" Ash N 79° W 120.88'
 Corner is 6' ± West of C/L "X" roads

L.C.R.C. #5022

Nail & Remon Tag in NE side clump 8" Ash N 27° W 54.28'
 Nail & Remon Tag in N side 14" Pear S 63° E 112.55' (m. 112.45')
 Nail & Remon Tag in S side 14" Ash N 79° W 120.88'
 Corner is 6' ± West of C/L "X" roads

The selected location is accepted by me and is generally accepted by professional surveyors as the best available evidence of the position of the original corner.

C. Description of monument for corner and accessories established to perpetuate locating the position of the corner:

C-9 Standard Kent County Monument in a Monument Box

- Nail & K.C. remon. tag on NE side 8" Ash Clump N 27° W 54.28'
- Nail & K.C. remon. tag on N side 14" Pear S 63° E 112.45'
- Nail & K.C. remon. tag on W side 14" Ash Clump N 15° E 131.79'
- Nail & K.C. remon. tag on S side Twin 12" Ash N 85° W 148.14'
- Nail & K.C. remon. tag on W side 14" Ash S 15° W 173.21'

Signed by Randy J. Kolehouse

Date 7/23/96

Surveyor's Michigan License No. 25854

