

SURVEY & REMONUMENTATION

FEB 14 1987

LAND CORNER RECORDATION CERTIFICATE
Filing Requirement of Act 74, Mich. P.A. 1970
KENT COUNTY REMONUMENTATION

For corners in

COMMISSION


Kent (County)	Located in:	Gainas Township	Corner Code #
1. Public Land Survey	T <u>5N</u>	R <u>11W</u>	<u>C-10</u>
	T _____	R _____	_____
	T _____	R _____	_____
	T _____	R _____	_____
2. Property Controlling in Section	S _____	T _____	R _____
	S _____	T _____	R _____
3. Miscellaneous Property in Sec.	S _____	T _____	R _____
	S _____	T _____	R _____

STATE OF MICHIGAN
 COUNTY OF KENT
 RECEIVED FOR RECORD
 96 AUG -8 AM 8:40
 REG. OF DEEDS
Lucy Bond

9230
 Register of Deeds Stamp & File number

4. Lot No. _____, Recorded Plat _____
 5. Private Claims _____

Randy Kolehouse, in a field survey on January 22 19 96, do hereby certify that under requirements of P.A. 74 Michigan P.A. of 1970, the corner points mentioned in lines 1 and 2 above were in conformance with regulations and rules therefore as required in the current manual of survey instructions of the United States Department of the interior, Bureau of Land Management or by a decree of a Court of Law and/or that the corner points mentioned in lines 3, 4 and 5 above were in conformance with the rules of the Michigan Board of Land Surveyors or by a Decree of a Court of Law; established, re-established, monumented, re-monumented, recovered, found as expressed below:

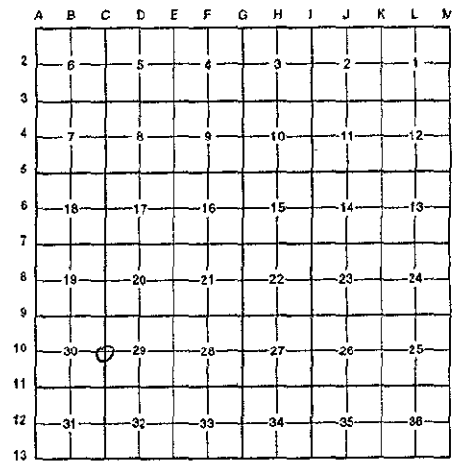

NOTE: Not more than 4 corners, all in the same town and range, may be recorded on this certificate.

A. Description of original monument and accessories and/or subsequent restoration:

C-10	1831	G.L.O. Notes	Mullet	Set Post
	N/A	Witness Map	K.C. Surveyor	Iron
	1973	L.C.R.C. #418	Medema, Van Kooten & Assoc.	1/2" Iron in Mon. Box
	1973	L.C.R.C. #510	Exxel Engineering	Monument Box
	1982	L.C.R.C. #3069	Jonker Land Surveys	Fnd. 1/2" Iron in Mon. Box / Set K.C. Monument
	1989	L.C.R.C. #5023	J. Bueche	K.C. Monument

P.A. 345 1990 KENT COUNTY
 PEER APPROVED 3/7/96
 CHAIRMAN *Randy Kolehouse*

This corner was originally approved by the Kent County Remonumentation Peer Group and monumented by Jonker Land Surveys on 8/5/82 and was recorded per L.C.R.C. #3069.

B. Description of corner evidence found and/or method applied in restoring or reestablishing corner:

C-10 Found a Standard Kent County Monument on the C/L of Eastern Avenue (bit.) running N-S on line of tree row running East per L.C.R.C.'s #3069 and #5023 as set by Rob Jonker in place of a 1/2" iron in a monument box he found which checked L.C.R.C.'s #418 and #510.

L.C.R.C. #3069

L.C.R.C. #5023

Remon. tag on W side p. pole S 15° E 185.36'	Nail & Remon Tag in E side 18" Walnut (6' high) N 20° W 90.13' (m. 90.06')
Remon. tag on E side 15" Walnut N 20° W 90.13'	Nail & Remon Tag in W side p. pole S 10° E 184.80' (m. 184.90')
Remon. tag on N side 3" Walnut N 90° E 57.52'	Nail & Remon Tag in N side group 6"-8" Ash N 90° E 57.42' (m. 57.32')
	Nail & Remon Tag in N side 10" Elm S 55° W 33.67' (m. 33.63')
	On C/L blacktop N-S
	On tree line East

The selected location is accepted by me and is generally accepted by professional surveyors as the best available evidence of the position of the original corner.

C. Description of monument for corner and accessories established to perpetuate locating the position of the corner:

C-10 Standard Kent County Monument

- Nail & K.C. remon. tag on E side 10" Elm N 25° E 141.06'
- Nail & K.C. remon. tag on E side 18" Walnut N 20° W 90.06'
- Nail & K.C. remon. tag on W side p. pole S 10° E 184.90'
- Nail & K.C. remon. tag on N side 6" Ash Clump N 90° E 57.32'
- Nail & K.C. remon. tag on N side 10" Elm S 55° W 33.63'

Signed by Randy J. Kolehouse
 EARTH TECH

Date 7/23/96

Surveyor's Michigan License No. 25854

