

SURVEY & REMONUMENTATION

FEB 14 1997

LAND CORNER RECORDATION CERTIFICATE
COMMISSION Filing Requirement of Act 74, Mich. P.A. 1970

For corners in Kent (County) Located in: Gaines Township Corner Code # _____


		Located in:	Gaines Township	Corner Code #
1. Public Land Survey	T <u>5N</u>	R <u>11W</u>		<u>C-11</u>
	T _____	R _____		_____
	T _____	R _____		_____
	T _____	R _____		_____
2. Property Controlling in Section	S _____	T _____	R _____	_____
	S _____	T _____	R _____	_____
3. Miscellaneous Property in Sec.	S _____	T _____	R _____	_____
	S _____	T _____	R _____	_____

STATE OF MICHIGAN
 COUNTY OF KENT
 RECEIVED FOR RECORD
 96 AUG - 8 AM 8:42
 REG. OF DEEDS
Lucy Stand

9231
 Register of Deeds Stamp & File Number

4. Lot No. _____, Recorded Plat _____
 5. Private Claims _____

Randy Kolehouse, in a field survey on January 22 19 96, do hereby certify that under requirements of P.A. 74 Michigan P.A. of 1970, the corner points mentioned in lines 1 and 2 above were in conformance with regulations and rules therefore as required in the current manual of survey instructions of the United States Department of the interior, Bureau of Land Management or by a decree of a Court of Law and/or that the corner points mentioned in lines 3, 4 and 5 above were in conformance with the rules of the Michigan Board of Land Surveyors or by a Decree of a Court of Law; established, re-established, monumented, re-monumented, recovered, found as expressed below:

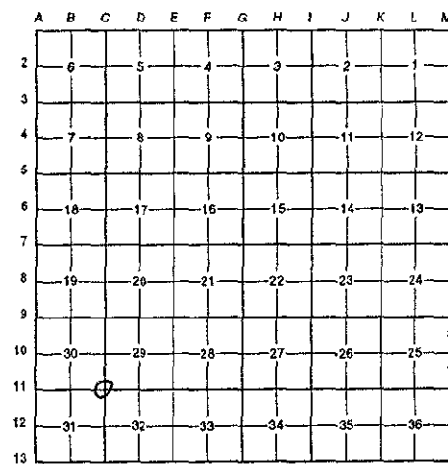

NOTE: Not more than 4 corners, all in the same town and range, may be recorded on this certificate.

A. Description of original monument and accessories and/or subsequent restoration:

C-11 1831	G.L.O. Notes	Mullett	Set Post	P.A. 345 1990 KENT COUNTY
1959	Witness Map	K.C. Surveyor	1/2" Iron in Mon. Box	PEER APPROVED <u>3/7/96</u>
1973	L.C.R.C. #510	Exxel Engineering	1/2" Iron in Mon. Box	CHAIRMAN <u>Randy Kolehouse</u>
1980	L.C.R.C. #1739	Williams & Works	Fnd. 3/4" Iron in Mon. Box / Set K.C. Monument	
1989	L.C.R.C. #5024	J. Bueche	K.C. Monument in Mon. Box	

This corner was originally approved by the Kent County Remonumentation Peer Group and monumented by Williams & Works on 12/22/80 and was recorded per L.C.R.C. #1739.

B. Description of corner evidence found and/or method applied in restoring or reestablishing corner:

C-11 Found a Standard Kent County Monument in a monument box at the C/L intersection of Eastern Avenue (bit.) and 100th Street (bit.) per L.C.R.C.'s #510, #1739 and #5024 as set by Williams & Works in place of a 3/4" iron they found which checked L.C.R.C. #510 and K.C. Surveyor's records.

L.C.R.C. #1739
 Nail & K.C. Remon. Tag in NE Side Tel. Power Pole S 30° W 78.00'
 Nail & K.C. Remon. Tag in West Side Tel. Power Pole N 15° W 77.07'
 C/L X of blacktop Rds. 100th & Eastern

L.C.R.C. #5024
 Nail & Remon Tag in NW side tel. power pole S 30° W 77.85' (m. 77.88')
 Nail & Remon Tag in West side tel. power pole N 15° W 77.23' (m. 77.02')
 SE cor. conc. porch floor to hse. N 45° W 166.22' (m. 166.19')
 Most Nely cor. hse. fnd. S 60° W 185.15'
 Cut at back of curb N 40° E 39.05'
 C/L X of blacktop rds. 100th & Eastern

The selected location is accepted by me and is generally accepted by professional surveyors as the best available evidence of the position of the original corner.

C. Description of monument for corner and accessories established to perpetuate locating the position of the corner:

C-11 Standard Kent County Monument in a Monument Box

- PK in NE side P. pole S 45° E 107.68'
- Cut @ back of curb N 40° E 39.05'
- Nail & K.C. remon. tag on E side P. pole N 15° W 77.02'
- SE cor. porch to hse. N 45° W 166.19'
- N NE'ly cor. hse. fnd. S 60° W 185.15'
- Nail & K.C. remon. tag on NW side P. pole S 30° W 77.88'

Signed by Randy J. Kolehouse EARTH TECH

Date 7/23/96

Surveyor's Michigan License No. 25854

