

FEB 14 1997

COMMISSION

**LAND CORNER RECORDATION CERTIFICATE**  
**Filing Requirement of Act 74, Mich. P.A. 1970**  
**KENT COUNTY REMONUMENTATION**

For corners in

Kent (County)	Located in: Gains Township	Corner Code #
1. Public Land Survey	T <u>5N</u> R <u>11W</u>	<u>C-13</u>
	T _____ R _____	_____
	T _____ R _____	_____
	T _____ R _____	_____
2. Property Controlling in Section	S _____ T _____ R _____	_____
	S _____ T _____ R _____	_____
3. Miscellaneous Property in Sec.	S _____ T _____ R _____	_____
	S _____ T _____ R _____	_____

REG. OF DEEDS

*Handwritten signature*

96 AUG -8 AM 8:42

STATE OF MICHIGAN  
 COUNTY OF KENT  
 RECEIVED FOR RECORD


**9233**

Register of Deeds Stamp & File Number

4. Lot No. \_\_\_\_\_, Recorded Plat \_\_\_\_\_  
 5. Private Claims \_\_\_\_\_

I, Randy Kolehouse, in a field survey on January 18 19 96, do hereby certify that under requirements of P.A. 74 Michigan P.A. of 1970, the corner points mentioned in lines 1 and 2 above were in conformance with regulations and rules therefore as required in the current manual of survey instructions of the United States Department of the interior, Bureau of Land Management or by a decree of a Court of Law and/or that the corner points mentioned in lines 3, 4 and 5 above were in conformance with the rules of the Michigan Board of Land Surveyors or by a Decree of a Court of Law; established, re-established, monumented, re-monumented, recovered, found as expressed below:

**NOTE: Not more than 4 corners, all in the same town and range, may be recorded on this certificate.**

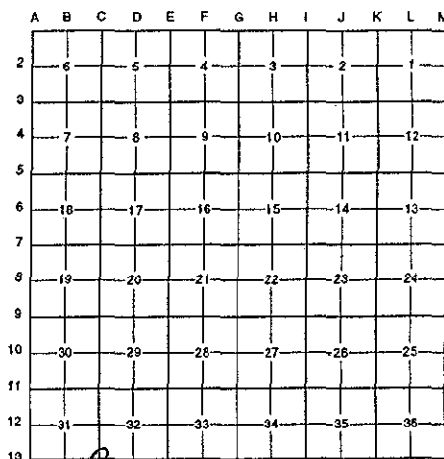

**A. Description of original monument and accessories and/or subsequent restoration:**

C-13	1817	G.L.O. Notes	L. Lyon	Set Post
	N/A	Witness Map	K.C. Surveyor	Iron
	1972	L.C.R.C. #319	F.E. Spicer	3/4" Iron
	1981	L.C.R.C. #1704	Williams & Works	Fnd. "T" Iron / Set K.C. Monument
	1989	L.C.R.C. #5026	J. Bueche	K.C. Monument

P.A. 345 1990 KENT COUNTY

PEER APPROVED 3/7/96

CHAIRMAN *Handwritten signature*

Note: This corner is not common with C-1, T4N, R11W.

This corner was originally approved by the Kent County Remonumentation Peer Group and monumented by Williams & Works on 2/18/81 and was recorded per L.C.R.C. #1704.

**B. Description of corner evidence found and/or method applied in restoring or reestablishing corner:**

C-13 Found a Standard Kent County Monument 30' East of C/L of Eastern Avenue (bit.) running N-S on Township line per L.C.R.C.'s #1704 and #5026 as set by Williams & Works in place of "T" iron they found which checked L.C.R.C. #319 and K.C. Surveyor's records.

L.C.R.C. #1704

L.C.R.C. #5026

Nail & K.C. Remon. Tag in E Side 28" Ash S 12° E 82.50'  
 Nail & K.C. Remon. Tag in NE Side 12" Poplar S 48° E 15.88'  
 C/L Blktp. Rd. Eastern Ave. West 30' ±  
 Bl. Spk. west 35.47', Tree Line West


New Nail & Remon Tag in E side 30" Ash S 12° E 82.50' (m. 82.35')  
 Nail & Remon Tag in NE side 16" Poplar S 48° E 15.75' (m. 15.75')  
 C/L blktp. rd. Eastern Ave. West 30' ±  
 Bl. Spk. West 35.47', Tree Line West

The selected location is accepted by me and is generally accepted by professional surveyors as the best available evidence of the position of the original corner.

**C. Description of monument for corner and accessories established to perpetuate locating the position of the corner:**

C-13 Standard Kent County Monument

- Nail & K.C. remon. tag on SE side P. pole 5' high S 25° W 144.92'
- Nail & K.C. remon. tag on NE side P. pole N 40° W 92.00'
- Nail & K.C. remon. tag on W side 10' Poplar N 25° E 18.14'
- Nail & K.C. remon. tag on NE side 16" Poplar S 48° E 15.75'
- Nail & K.C. remon. tag on E side 30" Ash S 12° E 82.35'
- Boat spike in monument box (Alleghen County Corner) West 35.44'

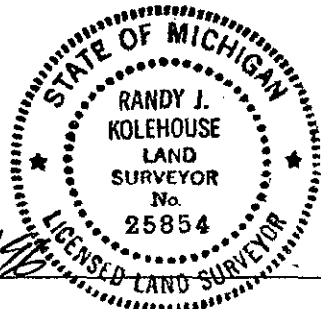

Signed by *Handwritten signature of Randy J. Kolehouse* Date 2/23/96  
 Surveyor's Michigan License No. 25854