

**SURVEY & REMONUMENTATION**

FEB 14 1997

COMMISSION


**LAND CORNER RECORDATION CERTIFICATE**  
**Filing Requirement of Act 74, Mich. P.A. 1970**  
**KENT COUNTY REMONUMENTATION**

For corners in

Kent (County)	Located in: Gains Township	Corner Code #
1. Public Land Survey	T <u>5N</u> R <u>11W</u>	<u>D-1</u>
	T _____ R _____	_____
	T _____ R _____	_____
	T _____ R _____	_____
2. Property Controlling in Section	S _____ T _____ R _____	_____
	S _____ T _____ R _____	_____
3. Miscellaneous Property in Sec.	S _____ T _____ R _____	_____
	S _____ T _____ R _____	_____

STATE OF MICHIGAN  
 COUNTY OF KENT  
 RECEIVED FOR RECORD  
 96 AUG -8 AM 8:42  
 REG. OF DEEDS  
*Lucy St. Paul*  
**9234**  
 Register of Deeds Stamp & File Number

4. Lot No. \_\_\_\_\_, Recorded Plat \_\_\_\_\_  
 5. Private Claims \_\_\_\_\_

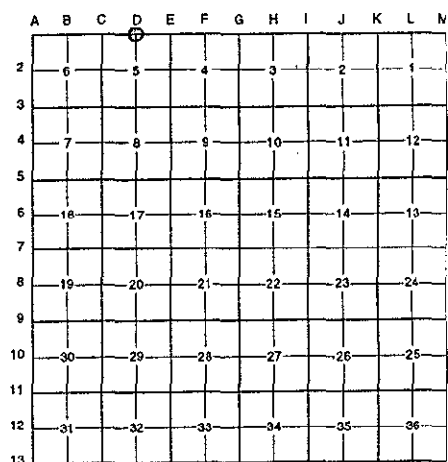

I, Randy Kolehouse, in a field survey on January 3 19 96, do hereby certify that under requirements of P.A. 74 Michigan P.A. of 1970, the corner points mentioned in lines 1 and 2 above were in conformance with regulations and rules therefore as required in the current manual of survey instructions of the United States Department of the interior, Bureau of Land Management or by a decree of a Court of Law and/or that the corner points mentioned in lines 3, 4 and 5 above were in conformance with the rules of the Michigan Board of Land Surveyors or by a Decree of a Court of Law; established, re-established, monumented, re-monumented, recovered, found as expressed below:

**NOTE: Not more than 4 corners, all in the same town and range, may be recorded on this certificate.**

**A. Description of original monument and accessories and/or subsequent restoration:**

D-1	This corner was not originally set by the G.L.O.		
1934	Witness Map	K.C. Surveyor	Iron
1976	L.C.R.C. #1296	Exxel Engineering	3/4" Iron
1983	L.C.R.C. #3469	William Byl	Fnd. 3/4" Iron / Set K.C. Monument
1992	L.C.R.C. #6544	J. Bueche	K.C. Monument

P.A. 345 1990 KENT COUNTY  
 PEER APPROVED 3/2/96  
 CHAIRMAN *Randy Kolehouse*

Note: This corner is not common with D-13, T6N, R11W.

This corner was originally approved by the Kent County Remonumentation Peer Group and monumented by William Byl on 7/21/83 and was recorded per L.C.R.C. #3469.

**B. Description of corner evidence found and/or method applied in restoring or reestablishing corner:**

D-1 Found a Standard Kent County Monument 3' M/L South of the C/L of 60th Street (bit.) running E & W and 20.50' East of K.C. Monument at D-13, T6N, R11W, per L.C.R.C.'s #1296, #3469, and #6544, as set by William Byl in place of a 3/4" iron he found which checked L.C.R.C. #1296 and ties to D-13, T6N, R11W.


L.C.R.C. #3469	L.C.R.C. #6544
Nail & tag S sd. MBT Pole N-65-E 60.09' (m. 60.91')	S'ly cor. fnd. to hse. #1211 N 10° E 89.90' (m. 89.64')
Most S'ly cor. fdn. Hse #1211 N-10-E 89.80'	PK in W side 12"-6" Maple S 25° E 53.70' (53.71')
	PK in W side 12" ch. Elm S 0° E 40.63' (m. 40.59')
	NW cor. hse. #1190 fnd. S 50° W (slope) 121.50' (m. 121.46')
	C/L bit. E-W 4' ± N
	K.C. Mon., S 1/4, 32, 6-11 West 20.49' (m. 20.50')

The selected location is accepted by me and is generally accepted by professional surveyors as the best available evidence of the position of the original corner.

**C. Description of monument for corner and accessories established to perpetuate locating the position of the corner:**

D-1 Standard Kent County Monument

S'ly cor. fnd. apt. #1211 N 10° E 89.64'  
 Nail & K.C. remon. tag on W side Tw. 12" Maple S 25° E 53.71'  
 Nail & K.C. remon. tag on W side 12" Chin. Elm S 00° E 40.59'  
 NW cor. hse. #1190 S 50° W 121.46'  
 NW cor. metal shed S 25° W 75.09'  
 K.C. Monument S 1/4 32, T6N, R11W, West 20.50'

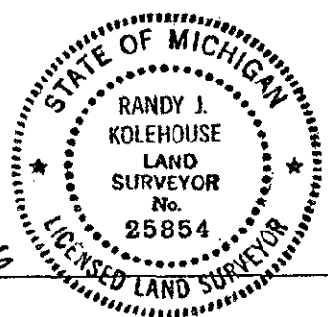

Signed by *Randy J. Kolehouse* Date 7/27/96  
 EARTH TECH

Surveyor's Michigan License No. 25854