

\$7.00
\$2.00

JAN 23 1996

LAND CORNER RECORDATION CERTIFICATE
Filing Requirement of Act 74, Mich. P.A. 1970
COMMISSION KENT COUNTY REMONUMENTATION

For corners in


Kent (County)	Located in:	Corner Code #
1. Public Land Survey	T <u>5N</u> R <u>11W</u>	<u>D-4</u>
	T _____ R _____	_____
	T _____ R _____	_____
	T _____ R _____	_____
2. Property Controlling in Section	S _____ T _____ R _____	_____
	S _____ T _____ R _____	_____
3. Miscellaneous Property in Sec.	S _____ T _____ R _____	_____
	S _____ T _____ R _____	_____

STATE OF MICHIGAN
COUNTY OF KENT
RECEIVED FOR RECORD
95 DEC 28 PM 2:21
REG. OF DEEDS
Lucy Stand

8905

Register of Deeds Stamp & File Number

4. Lot No. _____, Recorded Plat _____
5. Private Claims _____

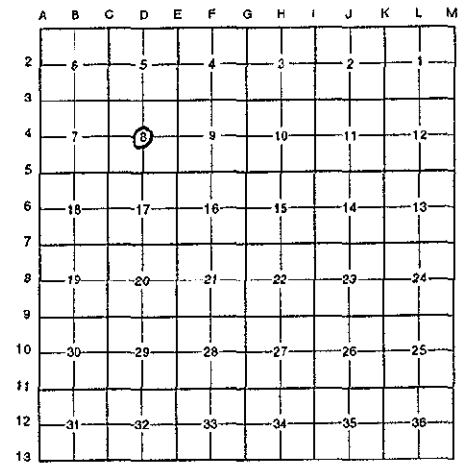

I, Randy Kolehouse, in a field survey on May 19 19 95, do hereby certify that under requirements of P.A. 74 Michigan P.A. of 1970, the corner points mentioned in lines 1 and 2 above were in conformance with regulations and rules therefore as required in the current manual of survey instructions of the United States Department of the Interior, Bureau of Land Management or by a decree of a Court of Law and/or that the corner points mentioned in lines 3, 4 and 5 above were in conformance with the rules of the Michigan Board of Land Surveyors or by a Decree of a Court of Law; established, re-established, monumented, re-monumented, recovered, found as expressed below:

NOTE: Not more than 4 corners, all in the same town and range, may be recorded on this certificate.

A. Description of original monument and accessories and/or subsequent restoration:

D-4 This corner was not originally set by the G.L.O.

1966 Survey Notes Williams & Works Set Iron at Intersection of 1/4 Lines
1.0' West and 0.5' North of Fence Corner

1988 Crystal Springs Plat L. 88 P. 28-29 Exxel Engineering P.A. 345 1990 KENT COUNTY
PEER APPROVED 10/26/95
CHAIRMAN *Harry Huber*

B. Description of corner evidence found and/or method applied in restoring or reestablishing corner:

D-4 Found Exxel iron per Crystal Springs Plat. Iron is 0.4' N and 0.3' E of intersection of 1/4 lines. Verified by Exxel Engineering Notes. Accepted iron as Center Section.

C. Description of monument for corner and accessories established to perpetuate locating the position of the corner:

D-4 Replaced the Exxel Engineering iron with Standrad 4" x 30" Kent County Monument.

- Nail & K.C. remon. tag in E side 6" Maple N 8° E 34.10'
- Nail & K.C. remon. tag in N side 22" Walnut N 90° W 28.19'
- Nail & K.C. remon. tag in W side 8" Maple S 10° E 28.09'
- NE cor. conc. foundation N 70° W 68.25'
- Capped 1/2" rebar 12579 Exxel, lot corner S 5° W 32.55'



Signed by *Randy J. Kolehouse* Date 12/22/95
EARTH TECH

Surveyor's Michigan License No. 25854