

**SURVEY & REMONUMENTATION**

FEB 14 1997

COMMISSION

**LAND CORNER RECORDATION CERTIFICATE**  
**Filing Requirement of Act 74, Mich. P.A. 1970**  
**KENT COUNTY REMONUMENTATION**


For corners in

Kent (County)	Located in:	Gaines Township	Corner Code #
1. Public Land Survey	T <u>5N</u>	R <u>11W</u>	<u>D-5</u>
	T _____	R _____	_____
	T _____	R _____	_____
	T _____	R _____	_____
2. Property Controlling in Section	S _____	T _____	R _____
	S _____	T _____	R _____
3. Miscellaneous Property in Sec.	S _____	T _____	R _____
	S _____	T _____	R _____

STATE OF MICHIGAN  
 COUNTY OF KENT  
 RECEIVED FOR RECORD  
 96 AUG -8 AM 8:42  
 REG. OF DEEDS  
*Lucy Bond*  
**9236**  
 Register of Deeds Stamp & File Number

4. Lot No. \_\_\_\_\_, Recorded Plat \_\_\_\_\_  
 5. Private Claims \_\_\_\_\_

I, Randy Kolehouse, in a field survey on January 23 19 96, do hereby certify that under requirements of P.A. 74 Michigan P.A. of 1970, the corner points mentioned in lines 1 and 2 above were in conformance with regulations and rules therefore as required in the current manual of survey instructions of the United States Department of the interior, Bureau of Land Management or by a decree of a Court of Law and/or that the corner points mentioned in lines 3, 4 and 5 above were in conformance with the rules of the Michigan Board of Land Surveyors or by a Decree of a Court of Law; established, re-established, monumented, re-monumented, recovered, found as expressed below:

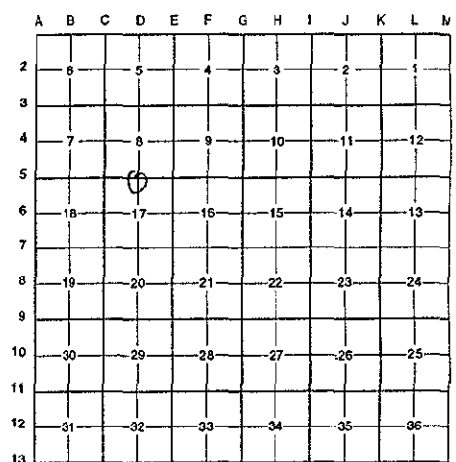

**NOTE:** Not more than 4 corners, all in the same town and range, may be recorded on this certificate.

**A. Description of original monument and accessories and/or subsequent restoration:**

D-5	1831	G.L.O. Notes	Mullett	Set Post
	1959	Witness Map	K.C. Surveyor	Concrete Monument
	1973	L.C.R.C. #416	Medema, Van Kooten & Assoc.	1/2" Iron
	1980	L.C.R.C. #1738	Williams & Works	Fnd. 1/2" Iron over Broken Conc. Mon. / Set K.C. Monument
	1989	L.C.R.C. #5028	J. Bueche	K.C. Monument

P.A. 345 1990 KENT COUNTY  
 PEER APPROVED 3/7/96  
 CHAIRMAN *Henry Fisher*

This corner was originally approved by the Kent County Remonumentation Peer Group and monumented by Williams & Works on 12/17/80 and was recorded per L.C.R.C. #1738.

**B. Description of corner evidence found and/or method applied in restoring or reestablishing corner:**

D-5 Found a Standard Kent County Monument 1.5' South of the C/L of 76th Street (bit.) running E-W on fence line running South per L.C.R.C.'s #1738 and #5028 as set by Williams & Works in place of a 1/2" iron and a broken concrete monument which checked L.C.R.C. #416 and K.C. Surveyor's records.

**L.C.R.C. #1738**

- Nail & K.C. Remon. Tag in NE Side 6" Dbl. Maple S 66° E 81.31'
- Nail & K.C. Remon. Tag in SW Side 30" Maple N 47° W 93.21'
- Nail & K.C. Remon. Tag in West Side Power Pole West 31.57'
- Nail & K.C. Remon. Tag in NW Side Group of Maples S 48° W 28.63'
- SE Cor. Porch to Hse. #187 Fnd. N 29° W 111.87'
- C/L Blacktop Rd. North 1.5' ±, on Fence Line North & South

**L.C.R.C. #5028**

- Nail & Remon Tag in NE side 10" dbl Maple S 66° E 81.31'
- Nail & Remon Tag in SW side 36" Maple N 47° W 93.21' (m. 92.46')
- Nail & Remon Tag in West side p. pole South 31.57'
- New Nail & Remon Tag in NW side group of Maples S 48° W 28.58' (m. 28.71')
- C/L blacktop rd North 1.5' ±, on fence line North & South
- Nail & Remon Tag in East side t. pole N 10° E 48.86'


The selected location is accepted by me and is generally accepted by professional surveyors as the best available evidence of the position of the original corner.

**C. Description of monument for corner and accessories established to perpetuate locating the position of the corner:**

- D-5 Standard Kent County Monument
- Nail & K.C. remon. tag on E side service pole North 48.87'
  - SE cor. porch hse. #1187 N 29° W 111.28'
  - Nail & K.C. remon. tag on SW side 30" Maple N 47° W 92.46'
  - Nail & K.C. remon. tag on NW side Group of Maples S 48° W 28.71'
  - Nail & K.C. remon. tag on W side P. pole South 31.57'
  - Nail & K.C. remon. tag on NE side 10" Dbl. Maple S 66° E 81.31'

Signed by *Randy J. Kolehouse*  
 EARTH TECH

Date 7/23/96

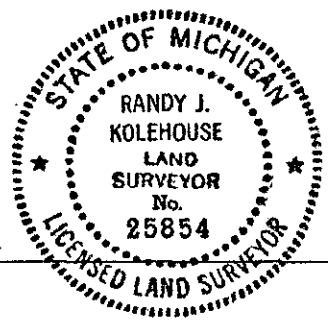

Surveyor's Michigan License No. 25854