

LAND SURVEY & REMONUMENTATION

FEB 14 1997

LAND CORNER RECORDATION CERTIFICATE
Filing Requirement of Act 74, Mich. P.A. 1970
KENT COUNTY REMONUMENTATION

For corners in COMMISSION

Kent (County)	Located in: Gaines Township	Corner Code #
1. Public Land Survey	T <u>5N</u> R <u>11W</u>	<u>D-9</u>
	T _____ R _____	_____
	T _____ R _____	_____
	T _____ R _____	_____
2. Property Controlling in Section	S _____ T _____ R _____	_____
	S _____ T _____ R _____	_____
3. Miscellaneous Property in Sec.	S _____ T _____ R _____	_____
	S _____ T _____ R _____	_____

STATE OF MICHIGAN
COUNTY OF KENT
RECEIVED FOR RECORD

96 AUG -8 AM 8:42

REG. OF DEEDS
Lucy Standa

9238
Register of Deeds Stamp & File Number

4. Lot No. _____, Recorded Plat _____
5. Private Claims _____

I, Randy Kolehouse, in a field survey on January 23 19 96, do hereby certify that under requirements of P.A. 74 Michigan P.A. of 1970, the corner points mentioned in lines 1 and 2 above were in conformance with regulations and rules therefore as required in the current manual of survey instructions of the United States Department of the interior, Bureau of Land Management or by a decree of a Court of Law and/or that the corner points mentioned in lines 3, 4 and 5 above were in conformance with the rules of the Michigan Board of Land Surveyors or by a Decree of a Court of Law; established, re-established, monumented, re-monumented, recovered, found as expressed below:

NOTE: Not more than 4 corners, all in the same town and range, may be recorded on this certificate.

A. Description of original monument and accessories and/or subsequent restoration:

D-9	1831	G.L.O. Notes	Mullett	Set Post
	1944	Witness Map	K.C. Surveyor	2" Pipe
	1972	L.C.R.C. #236	Williams & Works	"T" Iron
	1982	L.C.R.C. #2916	Exxel Engineering	Fnd "T" Iron in 2" Pipe / Set K.C. Monument
	1989	L.C.R.C. #5030	J. Bueche	K.C. Monument

P.A. 345 1990 KENT COUNTY
PEER APPROVED 3/7/96
CHAIRMAN Harry Stuber

	A	B	C	D	E	F	G	H	I	J	K	L	M
2	0	5	4	3	2	1							
3													
4	7	8	9	10	11	12							
5													
6	18	17	16	15	14	13							
7													
8	19	20	21	22	23	24							
9		20											
10	30	29	28	27	26	25							
11													
12	31	32	33	34	35	36							

This corner was originally approved by the Kent County Remonumentation Peer Group and monumented by Exxel Engineering on 6/4/82 and was recorded per L.C.R.C. #2916.

B. Description of corner evidence found and/or method applied in restoring or reestablishing corner:

D-9 Found a Standard Kent County Monument 3' M/L South of the C/L of 92nd Street (bit.) running E & W on brush and field division line running North per L.C.R.C.'s #236, #2916 and #5030 as set by Exxel Engineering in place of a "T" iron in the top of a 2" x 30" pipe they found which checked L.C.R.C. #236 and K.C. Surveyor's records.

L.C.R.C. #2916

L.C.R.C. #5030

PK & tag in E sde CP/MBT pole S 08° W 23.43'
C/L E-W road North 3'


PK & Remon Tag in E side CP/MBT pole S 08° W 23.33' (m. 23.33')
Nail & Remon Tag in W side wood fence post N 30° E 38.64' (m. 38.59')
C/L E-W road North 3'

The selected location is accepted by me and is generally accepted by professional surveyors as the best available evidence of the position of the original corner.

C. Description of monument for corner and accessories established to perpetuate locating the position of the corner:

D-9 Standard Kent County Monument

- Nail & K.C. remon. tag on S side 30" Maple N 83° E 294.00'
- Nail & K.C. remon. tag on E side P. pole S 08° W 23.33'
- Nail & K.C. remon. tag on N side 12" Tw. Elm S 85° W 227.68'
- Nail & K.C. remon. tag on W side wood fence post N 30° E 38.59'

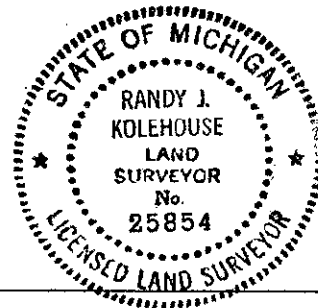

Signed by Randy J. Kolehouse
EARTH TECH

Date 7/23/96

Surveyor's Michigan License No. 25854