

\$7.00  
\$2.00

LAND SURVEY &  
MONUMENTATION

JAN 23 1996

LAND CORNER RECORDATION CERTIFICATE  
Filing Requirement of Act 74, Mich. P.A. 1970  
KENT COUNTY REMONUMENTATION

For corners in **COMMISSION**

Kent (County)	Located in:	Corner Code #
1. Public Land Survey	T <u>5N</u> R <u>11W</u>	<u>D-12</u>
	T _____ R _____	_____
	T _____ R _____	_____
	T _____ R _____	_____
2. Property Controlling in Section	S _____ T _____ R _____	_____
	S _____ T _____ R _____	_____
3. Miscellaneous Property in Sec.	S _____ T _____ R _____	_____
	S _____ T _____ R _____	_____


STATE OF MICHIGAN  
COUNTY OF KENT  
RECEIVED FOR RECORD

95 DEC 28 PM 2:21

REG. OF DEEDS  
*W. J. K. [Signature]*  
8909

Register of Deeds Stamp & File Number

- 4. Lot No. \_\_\_\_\_, Recorded Plat \_\_\_\_\_
- 5. Private Claims \_\_\_\_\_

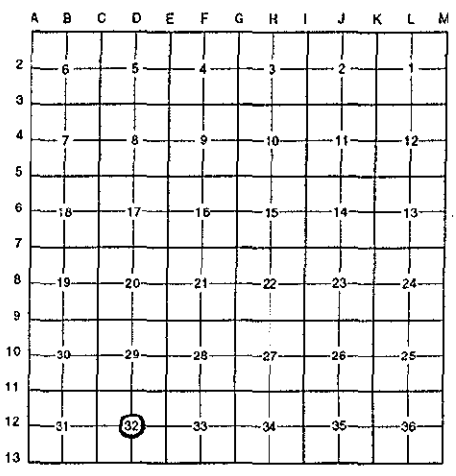

I, Randy Kolehouse, in a field survey on September 6 19 95, do hereby certify that under requirements of P.A. 74 Michigan P.A. of 1970, the corner points mentioned in lines 1 and 2 above were in conformance with regulations and rules therefore as required in the current manual of survey instructions of the United States Department of the interior, Bureau of Land Management or by a decree of a Court of Law and/or that the corner points mentioned in lines 3, 4 and 5 above were in conformance with the rules of the Michigan Board of Land Surveyors or by a Decree of a Court of Law; established, re-established, monumented, re-monumented, recovered, found as expressed below:

**NOTE: Not more than 4 corners, all in the same town and range, may be recorded on this certificate.**

**A. Description of original monument and accessories and/or subsequent restoration:**

D-12 This corner was not originally set by the G.L.O.

1911-1917	Survey Notes	Williams & Works	Iron at Int. of 1/4 Lines
1965	Wit. Map	K.C. Surveyor	Iron
1973	L.C.R.C. #509	Exxel Engineering	Fnd. 1/2" Iron in Mon. Box which Checks Williams & Works Witness

**B. Description of corner evidence found and/or method applied in restoring or reestablishing corner:**

D-12 Found a 1/2" iron per L.C.R.C. #509 and Exxel Engineering survey notes. Iron is within 0.5' of the intersection of 1/4 lines and has been used by Williams & Works since 1911. Accepted iron as Center Section.

L.C.R.C. #509

Nail in side 10" W. Cherry E 44.05'

P.A. 345 1990 KENT COUNTY  
PEER APPROVED 10/26/95  
CHAIRMAN [Signature]

**C. Description of monument for corner and accessories established to perpetuate locating the position of the corner:**

D-12 Replaced the 1/2" iron with a Standard 4" x 30" Kent County Monument.

- Nail w/cap in S side 18" Cherry N 85° E 43.78'
- P.K. E side 6" wood post S 07° W 0.65'
- Nail & K.C. remon. tag in S side 18" Cherry N 85° E 32.25'
- Nail & K.C. remon. tag in NE side 18" Maple N 62° W 226.74'
- Nail & K.C. remon. tag in SW'y side Clump 4" Elms N 26° W 19.14'



Signed by Randy Kolehouse Date 12/22/95  
EARTH TECH

Surveyor's Michigan License No. 25854