

SURVEY & REMONUMENTATION

FEB 14 1997

COMMISSION

LAND CORNER RECORDATION CERTIFICATE
Filing Requirement of Act 74, Mich. P.A. 1970
KENT COUNTY REMONUMENTATION

For corners in

Kent (County)	Located in:	Gaines Township	Corner Code #
1. Public Land Survey	T <u>5N</u>	R <u>11W</u>	<u>D-13</u>
	T _____	R _____	_____
	T _____	R _____	_____
	T _____	R _____	_____
2. Property Controlling in Section	S _____	T _____	R _____
	S _____	T _____	R _____
3. Miscellaneous Property in Sec.	S _____	T _____	R _____
	S _____	T _____	R _____

STATE OF MICHIGAN
 COUNTY OF KENT
 RECEIVED FOR RECORD
 96 AUG -8 AM 8:42
 REG. OF DEEDS
 9240
 Register of Deeds Stamp & File Number

4. Lot No. _____, Recorded Plat _____
 5. Private Claims _____

I, Randy Kolehouse, in a field survey on January 19 19 96, do hereby certify that under requirements of P.A. 74 Michigan P.A. of 1970, the corner points mentioned in lines 1 and 2 above were in conformance with regulations and rules therefore as required in the current manual of survey instructions of the United States Department of the Interior, Bureau of Land Management or by a decree of a Court of Law and/or that the corner points mentioned in lines 3, 4 and 5 above were in conformance with the rules of the Michigan Board of Land Surveyors or by a Decree of a Court of Law; established, re-established, monumented, re-monumented, recovered, found as expressed below:

	A	B	C	D	E	F	G	H	I	J	K	L	M
2	6		5		4		3		2		1		
3													
4	7		8		9		10		11		12		
5													
6	18		17		16		15		14		13		
7													
8	19		20		21		22		23		24		
9													
10	30		29		28		27		26		25		
11													
12	31		32		33		34		35		36		
13													

NOTE: Not more than 4 corners, all in the same town and range, may be recorded on this certificate.

A. Description of original monument and accessories and/or subsequent restoration:

D-13	1817	G.L.O. Notes	L. Lyon	Set Post
	1964	Witness Map	K.C. Surveyor	N/A
	1983	L.C.R.C. #3390	William Byl	Fnd. Iron Pipe / Set K.C. Monument
	1989	L.C.R.C. #5032	J. Bueche	K.C. Monument

P.A. 345 1990 KENT COUNTY
 PEER APPROVED 3/2/96
 CHAIRMAN Randy Kolehouse

Note: This corner is not common with D-1, T4N, R11W.


This corner was originally approved by the Kent County Remonumentation Peer Group and monumented by William Byl on 4/20/83 and was recorded per L.C.R.C. #3390.

B. Description of corner evidence found and/or method applied in restoring or reestablishing corner:
 D-13 Found a Standard Kent County Monument on C/L of abandoned Consumers Power Company right-of-way per L.C.R.C.'s #5032 and #3390 as set by William Byl in place of an iron pipe.

L.C.R.C. #3390	L.C.R.C. #5032
Nail & tag, S sd. 8" Walnut S 30° E 70.90' (m. 70.75')	K.C. Mon. between horiz. braces for pole #1403 in swamp
Nail & tag, S sd. 10" Ash S 60° E 55.40' (m. 55.34')	Nail & Remon Tag S side 12" Walnut S 30° E 70.90'
Nail & tag, E sd. 20" Maple S 50° W 67.80' (m. 67.85')	New Nail & Remon tag S side 14" Ash S 60° e 55.40'
Nail & tag, N sd. 12" Ash N 65° W 46.11' (m. 45.84')	Nail & Remon Tag E side 24" Maple S 50° W 67.80'
Cons. Power Co. iron, (N 1/4 cor. Sec. 5, 4-11) 69.90' (m. 70.80')	Nail & Remon Tag N side 14" Ash N 65° W 45.80'
	Cons. Power Co. Iron, (N 1/4 cor. Sec. 5, 4-11) West 69.90'

The selected location is accepted by me and is generally accepted by professional surveyors as the best available evidence of the position of the original corner.

C. Description of monument for corner and accessories established to perpetuate locating the position of the corner:
 D-13 Standard Kent County Monument
 Nail & K.C. remon. tag on S side 12" Walnut S 30° E 70.75'
 Nail & K.C. remon. tag on S side 14" Ash S 60° E 55.34'
 Nail & K.C. remon. tag on E side 24" Maple S 50° W 67.85'
 Nail & K.C. remon. tag on N side 14" Ash N 65° W 45.84'
 Allegan Co. Remon. Cap in pipe West 70.80' (N 1/4 cor. Sec. 5, T4N, R11W)

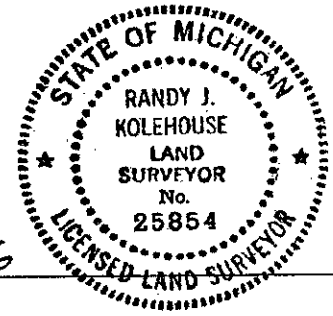

Signed by Randy J. Kolehouse Date 7/23/96
 EARTH TECH

Surveyor's Michigan License No. 25854